


STATE OF KANSAS
STATE CORPORATION COMMISSION

Give All Information Completely
Make Required Affidavit
Mail or Deliver Report to:
Conservation Division
State Corporation Commission
211 No. Broadway
Wichita, Kansas

WELL PLUGGING RECORD

NORTH

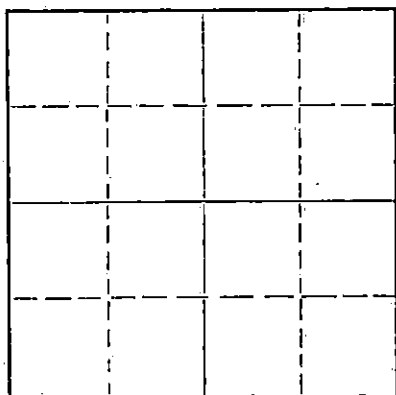

Locate well correctly on above
Section Plat

SUMNER

County: Sec. 14 Twp. 35S Rge. 3 (X) W (W)

Location as "NE/CNW/SW" or footage from lines. Approx. NW, SE, SE

Lease Owner ALLIED MATERIALS CORPORATION

Lease Name LARSEN "B" Well No. 1

Office Address ALLIED BLDG, 5101 N. PENNSYLVANIA, OKLAHOMA CITY

Character of Well (completed as Oil, Gas or Dry Hole) DRY ROTARY

Date well completed FEBRUARY 28, 19 60

Application for plugging filed FEBRUARY 28, 19 60

Application for plugging approved FEBRUARY 28, 19 60

Plugging commenced FEBRUARY 28, 19 60

Plugging completed FEBRUARY 29, 19 60

Reason for abandonment of well or producing formation No productable zone.

If a producing well is abandoned, date of last production 19

Was permission obtained from the Conservation Division or its agents before plugging was commenced? Yes

Name of Conservation Agent who supervised plugging of this well FRED W. HAMPEL

Producing formation Depth to top Bottom Total Depth of Well 5025' Feet

Show depth and thickness of all water, oil and gas formations.

OIL, GAS OR WATER RECORDS

CASING RECORD

FORMATION	CONTENT	FROM	TO	SIZE	PUT IN	PULLED OUT
				8 5/8"	294'	

Describe in detail the manner in which the well was plugged, indicating where the mud fluid was placed and the method or methods used in introducing it into the hole. If cement or other plugs were used, state the character of same and depth placed, from feet to feet for each plug set.

Gunned up pits, forming heavy mud, filled hole up to 240' with heavy mud, pushed plug and 1/4 sx. hulls to 240' and capped with 15 sx. cement through drill pipe.

Filled hole up to 40' with heavy mud, pushed wooden plug and 1/4 sx. hulls to 40', filled hole up to base of well cellar with 10 sx. cement.

(If additional description is necessary, use BACK of this sheet)

Name of Plugging Contractor GARVEY DRILLING COMPANY
Address ROUTE #2, GREAT BEND, KANSAS

STATE OF KANSAS, COUNTY OF BARTON, ss.
VERNE A. MORRIS

(employee of owner) (owner or operator) of the above-described well, being first duly sworn on oath, says: That I have knowledge of the facts, statements, and matters herein contained and the log of the above-described well as filed and that the same are true and correct. So help me God.

(Signature)

Verne A. Morris.
ROUTE #2, GREAT BEND, KANSAS
(Address)

SUBSCRIBED AND SWORN to before me this 29th day of FEBRUARY 19 60

My commission expires November 12, 1962

RECEIVED
STATE CORPORATION COMMISSION

Notary Public.

MAR 2 1960

CONSERVATION DIVISION
Wichita, Kansas

WELL LOG

COMPANY ALLIED MATERIALS CORPORATION

SEC. 14 T. 35S R. 3W

FARM LARSEN "B" NO. 1

LOC. Approx. NW, SE, SE


TOTAL DEPTH 5025'

COUNTY SUMNER CO., KANSAS

COMM. February 11, 1960 COMP. February 29, 1960

CONTRACTOR GARVEY DRILLING COMPANY

CASING 8 5/8" @ 294' w/250 sax.

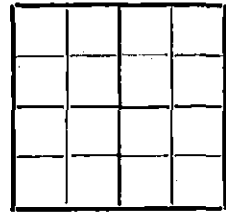

ELEVATION 1184' GL

PRODUCTION D & A

FIGURES INDICATE BOTTOM OF FORMATIONS

135	Surface soil & red rock
295	Red bed & shells
650	Shale & shells
895	Lime
1190	Lime & shale
1500	Shale & lime
3007	Lime & shale
3070	Shale & lime
3345	Lime & shale
3482	Sand & shale
3745	Lime & shale
3831	Shale & sand
3945	Lime & shale
4045	Lime
4302	Lime & shale
4355	Lime
4533	Lime & shale
4609	Lime & chert
4803	Lime
4842	Lime & shale
4956	Lime
4967	Lime & shale
5001	Sandy dolomite
5025	XXXX Simp. Sand
5025	T. D.

RECEIVED
STATE CORPORATION COMMISSION

MAR 2 1960

CONSERVATION DIVISION
Kansas

State of KANSAS

County of BARTON

SS:

I, VERNE A. MORRIS of GARVEY DRILLING COMPANY

upon oath state that the above and foregoing is a true and correct copy of the log of the #1 LARSEN "B" well.

Subscribed and sworn to before me this 29th day of February 1960

My Commission Expires: November 12, 1962

 NOTARY PUBLIC