

15-191-10234-0001  
9

STATE OF KANSAS  
STATE CORPORATION COMMISSION

Form CP-4

Give All Information Completely  
Make Required Affidavit  
Mail or Deliver Report to:  
Conservation Division  
State Corporation Commission  
212 No. Market  
Wichita, Kansas 67202

WELL PLUGGING RECORD

Sumner County, Sec. 9 Twp. 35 Rge. 3 (E) (W)

Location as "NE/CNW/SW" or footage from lines NE SW NE

Lease Owner Texaco, Inc.

Lease Name F.A. Hudson #3 (Fall Creek #3) Well No. #3

Office Address Great Bend, Kansas 67530

Character of Well (completed as Oil, Gas or Dry Hole)

Date well completed 19

Application for plugging filed 19

Application for plugging approved 19


Plugging commenced 10/28/70 19

Plugging completed 10/30/70 19

Reason for abandonment of well or producing formation depleted.

If a producing well is abandoned, date of last production 19

Was permission obtained from the Conservation Division or its agents before plugging was commenced? yes

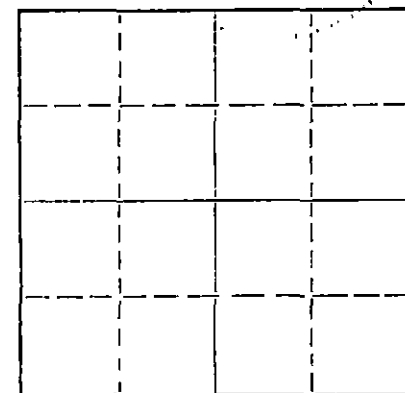

Locate well correctly on above Section Plat

Name of Conservation Agent who supervised plugging of this well Hess

Producing formation Depth to top Bottom Total Depth of Well 4818 Feet

Show depth and thickness of all water, oil and gas formations.

OIL, GAS OR WATER RECORDS

CASING RECORD

FORMATION	CONTENT	FROM	TO	SIZE	PUT IN	PULLED OUT
				8-5/8	611	none
				5 1/2"	4818	2514'

Describe in detail the manner in which the well was plugged, indicating where the mud fluid was placed and the method or methods used in introducing it into the hole. If cement or other plugs were used, state the character of same and depth placed, from feet to feet for each plug set.

Sanded hole to 4780', set 5 sacks of cement. Rigged up on 5 1/2".  
Shot pipe at 2180', worked pipe to 30" tension. Shot pipe at  
2530', pulled 80 joints. Bailed hole to 300', set rock bridge  
and ran 30 sacks of cement. Mudded hole to 25', ran 5 sacks of  
cement.

PLUGGING COMPLETE.

RECEIVED  
STATE CORPORATION COMMISSION  
NOV 9 1970  
CONSERVATION DIVISION  
Wichita, Kansas

(If additional description is necessary, use BACK of this sheet)

Name of Plugging Contractor KNIGHT CASING PULLING CO., INC.

Address CHASE, KANSAS

STATE OF KANSAS, COUNTY OF RICE, ss.

NOEL J. KNIGHT (employee of owner) or (owner or operator) of the above-described

well, being first duly sworn on oath, says: That I have knowledge of the facts, statements, and matters herein contained and the log of the above-described well as filed and that the same are true and correct. So help me God.

(Signature) Noel Knight

CHASE, KANSAS (Address)

SUBSCRIBED AND SWORN to before me this 5th day of November, 1970

2/15/71

My commission expires

Notary Public

15-191-10234-000  
9-35-3W

Record of Well No. 3

Owned by MAGNOLIA PETROLE

Farm F.A. Hudson County Sumner State Kansas  
1650' FNL 990' FWL Sec. 9, 35S,  
District El Dorado Elevation 1128' K.B.M.

Rig Commenced				
Rig Completed				
Drilling Commenced	6	27	1951	Barnett Drilling Inc.
Drilling Completed	7	27	1951	Wichita, Kansas
Torpedoed	None etc.			

Kind	Put In		Pulled		Left In		REMARKS
	Ft.	In.	Ft.	In.	Ft.	In.	
8" OD 28# 8 V. Thd. L.W. Casing	611	0					Cemented w/425 sacks.
7" OD 17# 8 Rd. Thd. H-40 Seamless"	4818	0					Cemented w/500 sacks
7# 8 Rd. Thd. EUE J-55 Seamless tubing	4764						

Transfer in No. 4908 Our No.  
Estimated Oil Production 289 Bbls. Gas None Cu Ft.  
Voucher No.

FORMATION	TOP	BOTTOM	REMARKS
Surface Clay & Sand	0	40	8-5/8" casing set at 611' K.
Shale & Shells	40	611	Cemented w/425 sacks
Shale & Lime	611	1085	
Shale & Shells	1085	2365	
Shale & Lime	2365	2450	
Shale & Shells	2450	2555	
Shale & Lime	2555	2700	
Shale & Shells	2700	2815	
Shale & Lime	2815	3185	
Lime & Shale	3185	3320	
Shale & Lime	3320	3400	
Lime & Shale	3400	4205	Top of Kansas City lime 3669
Shale & Lime	4205	4265	
Lime & Shale	4265	4350	
Lime, Shale & Chat	4350	4380	Top of Mississippi lime 4354
Chert & Lime	4380	4389	
Cherty Lime & Shale	4389	4410	
Lime	4410	4428	
Lime & Chert	4428	4475	
Lime	4475	4738	Top of Kinderhook lime 4693'
Lime & Shale	4738	4755	
Lime	4755	4775	Top of Viola lime 4769' K.B.
CORED	4775	4818	
Lime	4775	4776	Top of Simpson sand 4776' K.
Lime, Brown w/ Slight odor & stain	4776	4784	
Lime	4784	4786	
Lime w/odor & Light shows oil	4786	4787	
Lime w/stain & odor	4787	4790	
Lime	4790	4792	
Dolomite, Sandy Saturated w/oil	4792	4793	
Sand w/Light Sat. & Staining	4793	4803	
Dolomite, Sandy, Saturated w/Light show - oil	4803	4811	5-1/2" casing set at 4818' K
Sand, Saturated w/ Light oil	4811	4818	Cemented w/500 sacks.
Total Depth	4818		K.B.M.

RECAP

Total Depth Drilled 4818'  
Depth Casing Set ( Oil String) 4818'  
Plug Back Depth 0'

SEE REVERSE SIDE FOR REMARKS

RECEIVED  
STATE CORPORATION COMMISSION  
K.B.M. OCT 5 1970  
K.B.M. CONSERVATION DIVISION  
Wichita, Kansas