

STATE OF KANSAS
STATE CORPORATION COMMISSION

Give All Information Completely
Make Required Affidavit
Mail or Deliver Report to:
Conservation Division
State Corporation Commission
800 Bittling Building
Wichita, Kansas

WELL PLUGGING RECORD

Summer County. Sec. 3 Twp. 35 Rge. 3 (EX) (W)

Location as "NE/CNW*SW*" or footage from lines C-SW/4 NW/4 SE/4

Lease Owner Midstates Oil Corporation

Lease Name F. A. Hudson Well No. 1

Office Address

Character of Well (completed as Oil, Gas or Dry Hole) Dry Hole

Date well completed July 1, 1952 19

Application for plugging filed July 2, 1952 19

Application for plugging approved July 8, 1952 19


Plugging commenced July 14, 1952 19

Plugging completed July 21, 1952 19

Reason for abandonment of well or producing formation Dry Hole

If a producing well is abandoned, date of last production None 19

Was permission obtained from the Conservation Division or its agents before plugging was commenced? Yes

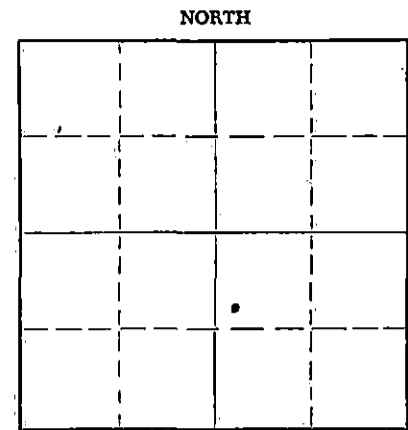

Name of Conservation Agent who supervised plugging of this well Mr. W. G. Buffington

Producing formation KC Depth to top 3678' Bottom 3696' Total Depth of Well 4833' Feet

Show depth and thickness of all water, oil and gas formations.

OIL, GAS OR WATER RECORDS

CASING RECORD

FORMATION	CONTENT	FROM	TO	SIZE	PUT IN	PULLED OUT
				8-5/8"	605'	0
				5-1/2"	3767'	2995'

Describe in detail the manner in which the well was plugged, indicating where the mud fluid was placed and the method or methods used in introducing it into the hole. If cement or other plugs were used, state the character of same and depth placed, from _____ feet to _____ feet for each plug set.

24' of crushed rock and 5 sacks cement (Plug) Filled to 3671' (7' above perforations) Loaded hole to 600' with rotary mud. 5' crushed rock and 20 sacks cement. Filled hole with mud to 31' from ground surface. 31' of cement to ground surface.

(If additional description is necessary, use BACK of this sheet)

Name of Plugging Contractor Gabbert-Jones Drilling Company

Address 701 Petroleum Building, Wichita, Kansas

STATE OF Oklahoma, COUNTY OF Tulsa, ss. W. H. Barclay (employee of owner or contractor) of the above-described well, being first duly sworn on oath, says: That I have knowledge of the facts, statements, and matters herein contained and the log of the above-described well as filed and that the same are true and correct. So help me God.

(Signature) W. H. Barclay

518 N.B.T. Bldg., Tulsa, Oklahoma (Address)

SUBSCRIBED AND SWORN TO before me this 25th day of July, 19 52

Betty June Sawyer Notary Public.

My commission expires My Commission Expires March 21, 1955

PLUGGING
FILE SEC-3 T 35 R 36
BOOK PAGE 28 LINE 5

AUG - 2 1952 8-2-52
CONSERVATION DIVISION
Wichita, Kansas

<u>Formation</u>	<u>Top</u>	<u>Bottom</u>
Shale & Shells	0	515
Lime	515	612
Lime	612	705
Lime & Shale	705	1340
Shale & Shells	1340	1520
Lime & Shale	1520	1605
Shale & Shells	1605	1875
Shale & Lime	1875	1990
Shale & Shells	1990	2225
Lime	2225	2250
Shale & Lime	2250	2965
Shale	2965	2968
Shale & Lime	2968	3150
Shale	3150	3590
Lime & Shale	3590	3620
Lime	3620	4065
Lime & Shale	4065	4225
Shale	4225	4310
Lime	4310	4370
Lime & Chert	4370	4404
Lime	4404	4588
Lime & Chert	4588	4598
Lime & Shale	4598	4635
Shale	4635	4670
Shale & Lime	4670	4755
Coring	4755	4808
Sand	4808	4833

4833 T.D.

... (faint, illegible text) ...

... (faint, illegible text) ...

... (faint, illegible text) ...

