


15-191-10224-0001

STATE OF KANSAS
STATE CORPORATION COMMISSION
Give All Information Completely
Make Required Affidavit
Mail or Deliver Report to:
Conservation Division
State Corporation Commission
800 Bitting Building
Wichita, Kansas

WELL PLUGGING RECORD

Sumner County, Sec. 3 Twp. 35S Rge. 3W (E) (W)

Location as "NE/CNW $\frac{1}{4}$ SW $\frac{1}{4}$ " or footage from lines SW SE NW
Lease Owner The Texas Company
Lease Name L. T. Dvorak Well No. 1
Office Address 614 Bitting Building, Wichita, Kansas
Character of Well (completed as Oil, Gas or Dry Hole) Dry
Date well completed January 7 1951
Application for plugging filed May 15 1952
Application for plugging approved May 16 1952
Plugging commenced June 3 1952
Plugging completed June 4 1952
Reason for abandonment of well or producing formation
If a producing well is abandoned, date of last production 19
Was permission obtained from the Conservation Division or its agents before plugging was commenced?

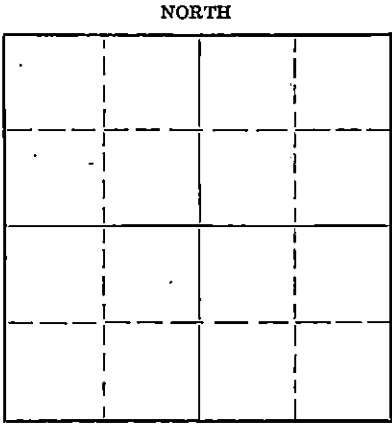

Locate well correctly on above Section Flat

Name of Conservation Agent who supervised plugging of this well
Producing formation Depth to top Bottom Total Depth of Well 5117' Feet
Show depth and thickness of all water, oil and gas formations. PBTB 3746'

OIL, GAS OR WATER RECORDS

CASING RECORD

Formation	Content	From	To	Size	Put In	Pulled Out
				10-3/4"	611'	0'
				5-1/2"	4913'	1709'

Describe in detail the manner in which the well was plugged, indicating where the mud fluid was placed and the method or methods used in introducing it into the hole. If cement or other plugs were used, state the character of same and depth placed, from feet to feet for each plug set.

PLUGGED AS FOLLOWS:

3746' to 612' Heavy Mud
Plug at 612'
612' to 550' 15 Sacks Cement
550' to 18' - Heavy Mud
Plug at 18'
18' to top of surface - 10 Sacks Cement

RECEIVED
STATE CORPORATION COMMISSION
JUN 7 - 1952
6-7-52
CONSERVATION DIVISION
Wichita, Kansas

Name of Plugging Contractor L & F Casing Pulling Company
Address Box 294, Russell, Kansas

STATE OF Kansas, COUNTY OF Sedgwick, ss.
M. C. Harrell (employee of owner) or (owner or operator) of the above-described well,
being first duly sworn on oath, says: That I have knowledge of the facts, statements, and matters herein contained and the log of the above-described well as filed and that the same are true and correct. So help me God.

(Signature) M. C. Harrell
614 Bitting Bldg., Wichita, Kansas
(Address)

SUBSCRIBED AND SWORN to before me this 5th day of June 1952
H. Howard Kistler
Notary Public.

My commission expires September 20, 1952

PLUGGING
FILE SEC 3 T. 35 R. 3W
BOOK PAGE 16 LINE 11

LOG OF WELL

SHEET NO. _____

District Kansas Owner The Texas Co. Farm L. T. Dvorak Well No. 1

FORMATION	AMOUNT	COLOR	HARD OR SOFT	DEPTH CORES TAKEN	REMARKS
Sand, shale & shells	210				CASING RECORD: 10-3/4" cog set at 611' w/450 sacks cmt. 5-1/2" cog set at 4913' w/700 sacks cmt. ELEVATION: 1152 KB 1150 DF TOPS: Stainaker.....3152 Layton.....3612 Kansas City.....3662 B/Kansas City....3864 Marston.....3926 Cherokee.....4084 Mississippian....4374 Kinderhook.....4750 Miscner.....4802 Viola.....4808 Simpson.....4818 Arbuckle.....5033 T.D.....5117 P.B.T.D.....3746
Lime shells & shale	395				
Salt, shale & shells	455				
Shale & shells	613				
Lime & shale streaks	860				
Lime & shale	1055				
Shale & lime	1235				
Lime & shale	1685				
Shale & lime	1875				
Shale & shells	2065				
Lime	2105				
Shale & lime shells	2185				
Shale & lime	2265				
Lime	2295				
Shale & lime	2390				
Lime	2465				
Lime & shale	3030				
Shale	3085				
Shale & lime shells	3180				
Shale & shells	3230				
Sand & shale	3290				
Sand	3362				
Shale	3380				
Shale & lime	3456				
Shale	3587				
Sand	3598				
Shale	3663				
Lime	3671				
K. C. Lime	3877				
Lime & shale	4080				
Lime	4281				
Lime & shale	4331				
Lime	4332				
Chert	4361				
Lime & chert	4380				
Lime & chert	4420				
Chert	4437				
Lime & chert	4445				
Cherty lime	4471				
Chert & lime	4538				
Lime & chert	4550				
Lime	4707				
Shale & lime	4720				
Lime	4741				
Cherty lime	4753				
Lime & shale	4775				
Shale & lime	4788				
Coring	4798				
Shale	4808				
Coring	4825				
Sand	4829				
Coring	4916				
Shale	4917				
Coring	4953				
Shale & sand	4987				
Lime	4992				
Shale, sand & shells	5012				
Lime & shale	5020				
Coring	5117				
T. D.	5117				
P.B.T.D.	3746				

PLUGGING
 FILE REC 3 T 35 R 3 W
 BOOK PAGE 16 LINE 11

RECEIVED
 STATE CORPORATION COMMISSION
 APR 15 1952
 CONSERVATION DIVISION
 Wichita, Kansas