


STATE OF KANSAS
STATE CORPORATION COMMISSION

Give All Information Completely
Make Required Affidavit
Mail or Deliver Report to:
Conservation Division
State Corporation Commission
800 Bitting Building
Wichita, Kansas

WELL PLUGGING RECORD

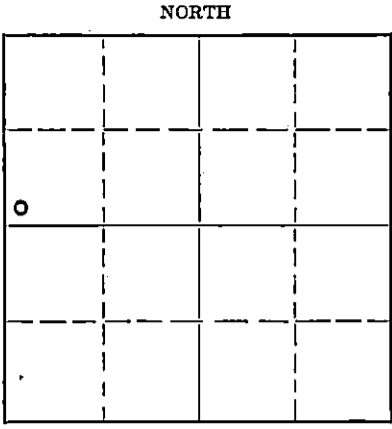

Locate well correctly on above
Section Flat

Summer County. Sec. 3 Twp. 35 Rge. 3 (E) W (W)
Location as "NE/CNW $\frac{1}{4}$ /SW $\frac{1}{4}$ " or footage from lines SW $\frac{1}{4}$ SW $\frac{1}{4}$ NW $\frac{1}{4}$
Lease Owner Metropolitan Petroleum Corporation of New York
Lease Name Dvorak Well No. 1
Office Address 320 Union National Bank Bldg., Wichita, Kansas
Character of Well (completed as Oil, Gas or Dry Hole) dry hole
Date well completed March 12, 1952
Application for plugging filed March 12, 1952
Application for plugging approved March 12, 1952
Plugging commenced March 12, 1952
Plugging completed March 12, 1952
Reason for abandonment of well or producing formation dry hole

If a producing well is abandoned, date of last production 19
Was permission obtained from the Conservation Division or its agents before plugging was commenced? yes

Name of Conservation Agent who supervised plugging of this well W. G. Buffington
Producing formation Depth to top Bottom Total Depth of Well 4866 Feet
Show depth and thickness of all water, oil and gas formations.

OIL, GAS OR WATER RECORDS CASING RECORD

Formation	Content	From	To	Size	Put In	Pulled Out
		0	621	8 5/8"	621	8 feet

Describe in detail the manner in which the well was plugged, indicating where the mud fluid was placed and the method or methods used in introducing it into the hole. If cement or other plugs were used, state the character, size and depth placed, from feet to feet for each plug set.

Filled hole with heavy mud from 4866' to 621 feet. Set wooden plug at 621 feet. Filled with one-half sack of hulls and 15 sacks of cement to 571 feet. Filled with heavy mud to 25 feet. Set wooden plug at 25 feet. Dumped one-half sack of hulls on plug and filled to bottom of cellar with 10 sacks of cement. Cut off surface pipe at bottom of cellar and welded on cap.

3-15-52

(If additional description is necessary, use BACK of this sheet)

Name of Plugging Contractor Barnett Drilling, Inc.
Address 623 First National Bank Bldg., Wichita, Kansas

STATE OF Kansas, COUNTY OF Sedgwick, ss.
F. R. Stubblefield (employee of owner) or (owner or operator) of the above-described well,

being first duly sworn on oath, says: That I have knowledge of the facts, statements, and matters herein contained and the log of the above-described well as filed and that the same are true and correct. So help me God.

(Signature) *F. R. Stubblefield*
623 First Nat'l Bank Bldg., Wichita, Kansas
(Address)

SUBSCRIBED AND SWORN TO before me this 14th day of March, 1952

William F. Willis
Notary Public.

My commission expires 2-27-56

23-8390-s 6-51-20M
PLUGGING
FILE SEC 3 T 35 R 3W
PAGE 1 LINE 14

BARNETT DRILLING, INC.

LOG OF DVORAK WELL NO. 1

SW $\frac{1}{4}$ SW $\frac{1}{4}$ NW $\frac{1}{4}$ SECTION 3-35S-3W, SUMNER COUNTY, KANSAS

DATE COMMENCED: February 9, 1952

DATE COMPLETED: March 13, 1952


<u>Formation</u>	<u>From</u>	<u>To</u>	<u>Remarks</u>
Red Bed	0	60	
Red Bed and Sand	60	120	
Red Bed and Shells	120	320	
Shale and Shells	320	617	
Lime	617	621	Set 8 5/8" Surface Pipe @ 621 feet; Cemented with 350 sacks.
Lime and Shale	621	990	
Lime	990	1370	
Lime and Shale	1370	1500	
Lime	1500	1613	
Shale and Lime	1613	2040	
Lime	2040	2150	
Lime and Shale	2150	3025	
Shale	3025	3170	
Lime and Shale	3170	3275	
Sand and Shale	3275	3375	
Shale and Lime	3375	3465	
Shale	3465	3640	
Shale and Lime	3640	3680	
Lime	3680	3840	
Shale and Lime	3840	4005	
Shale	4005	4023	
Shale and Lime	4023	4100	
Lime	4100	4124	
Lime and Shale	4124	4255	
Lime	4255	4283	
Lime and Shale	4283	4316	
Shale	4316	4377	
Shale and Lime	4377	4403	
Lime	4403	4760	
Lime and Shale	4760	4769	
Shale	4769	4790	
Lime	4790	4834	
Sand	4834	4866	
Total Depth		4866	Dry and Abandoned.

Certificate.

I, F. R. Stubblefield, of Barnett Drilling, Inc., hereby certify that to the best of my knowledge and belief, the above is a true and correct log of the Dvorak Well No. 1, located in the SW $\frac{1}{4}$ SW $\frac{1}{4}$ NW $\frac{1}{4}$ of Section 3-35S-3W, Sumner County, Kansas.

F. R. Stubblefield

Subscribed and sworn to before me, in and for the County of Sedgwick, State of Kansas, this 14th day of March, 1952.

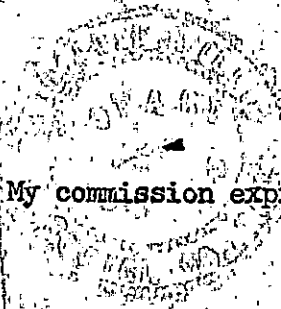

PLUGGING
FILE SEC 3 T 35 R 30
BOOK PAGE 1 LINE 14

Milled F. Willis
Notary Public

My commission expires: February 27, 1956