


STATE OF KANSAS
STATE CORPORATION COMMISSION

WELL PLUGGING RECORD

Give All Information Completely
Make Required Affidavit
Mail or Deliver Report to
Conservation Division
State Corporation Comm.
245 North Water
Wichita, KS 67202

Kingman County. Sec. 12 Twp. 29S Rge. 10W ~~XX~~/W
Location as "NE/CNW $\frac{1}{4}$ /SW $\frac{1}{4}$ " or footage from lines
C W/2 SE

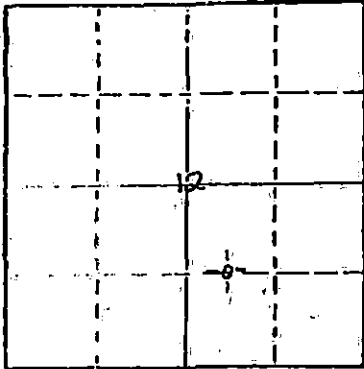

Locate well correctly on above
Section Plot

Lease Owner Associated Petroleum Consultants, Inc.
Lease Name Steffen Well No. #2
Office Address Suite 600 - One Main Place, Wichita, KS 67202
Character of Well (Completed as Oil, Gas or Dry Hole)
Dry Hole
Date Well completed July 24, 1982
Application for plugging filed July 24, 1982
Application for plugging approved July 24, 1982
Plugging commenced 11:00 a.m. 7-24 1982
Plugging completed 1:15 p.m. 7-24 1982
Reason for abandonment of well or producing formation
D & A
If a producing well is abandoned, date of last production
None 19

Was permission obtained from the Conservation Division or
its agents before plugging was commenced? yes

Name of Conservation Agent who supervised plugging of this well Maurice Leslie - Nashville, KS
Producing formation X Depth to top X Bottom X Total Depth of Well 2600'
Show depth and thickness of all water, oil and gas formations.

OIL, GAS OR WATER RECORDS

CASING RECORD

FORMATION	CONTENT	FROM	TO	SIZE	PUT IN	PULLED OUT
				8 5/8"	326'	none

Describe in detail the manner in which the well was plugged, indicating where the mud fluid
was placed and the method or methods used in introducing it into the hold. If cement or other
plugs were used, state the character of same and depth placed, from _____ feet to
_____ feet for each plug set.

Ran 60 sacks @ 950'
40 sacks @ 310'
10 sacks and plug @ 40'
5 sacks rathole
5 sacks mousehole

(If additional description is necessary, use BACK of this sheet)

Name of Plugging Contractor Heartland Drilling, Inc.

STATE OF KANSAS COUNTY OF SEDGWICK, ss.
PHYLLIS BUCHANAN (employee of owner) or ~~owner or operator~~
of the above-described well, being first duly sworn on oath, says: That I have knowledge of
the facts, statements, and matters herein contained and the log of the above-described well
as filed and that the same are true and correct. So help me God.

(Signature) Phyllis Buchanan
PHYLLIS BUCHANAN

SUBSCRIBED AND SWORN TO before me this 30th day of July, 1982

My commission expires

Sherry Wayman
SHERRY WAYMAN Notary Public.



RECEIVED
STATE CORPORATION COMMISSION
AUG 04 1982
CONSERVATION DIVISION
Wichita, Kansas