

STATE OF KANSAS
STATE CORPORATION COMMISSION

WELL PLUGGING RECORD

Give All Information Completely
Make Required Affidavit
Mail or Deliver Report to
Conservation Division
State Corporation Comm.
245 North Water
Wichita, KS 67202

Kingman County, Sec. 12 Twp. 29S Rge. 10W E/W
Location as "NE/CNW 1/4 SW 1/4" or footage from lines
C SE NE

Lease Owner Assoc. Petr. Consult. & S. I. Resources
Lease Name Hoover Well No. #1
Office Address Suite 600 - One Main Place, Wichita, KS 67202


Character of Well (Completed as Oil, Gas or Dry Hole)
Dry Hole

Date Well completed May 30, 1982 19
Application for plugging filed May 30, 1982 19
Application for plugging approved May 30, 1982 19
Plugging commenced 11:30 a.m. 19
Plugging completed 2:30 p.m. 19

Reason for abandonment of well or producing formation
D & A

If a producing well is abandoned, date of last production
None 19

Was permission obtained from the Conservation Division or
its agents before plugging was commenced? yes

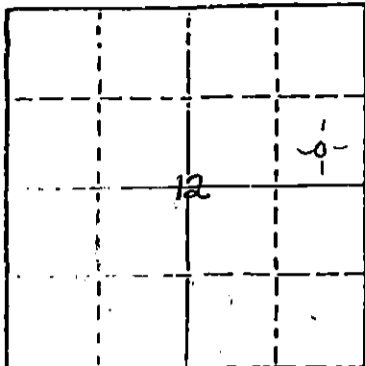

Locate well correctly on above
Section Plot

Name of Conservation Agent who supervised plugging of this well
Producing formation X Depth to top X Bottom X Total Depth of Well 2598'
Show depth and thickness of all water, oil and gas formations.

OIL, GAS OR WATER RECORDS

CASING RECORD

FORMATION	CONTENT	FROM	TO	SIZE	PUT IN	PULLED OUT
				8 5/8"	332'	none

Describe in detail the manner in which the well was plugged, indicating where the mud fluid
was placed and the method or methods used in introducing it into the hold. If cement or other
plugs were used, state the character of same and depth placed, from _____ feet to
_____ feet for each plug set.

Ran 60 sacks at 1250'
40 sacks @ 320'
10 sacks at 40' bridge plug
10 sacks in rat hole
5 sacks in mouse hole

(If additional description is necessary, use BACK of this sheet)

Name of Plugging Contractor Heartland Drilling, Inc.


STATE OF KANSAS COUNTY OF SEDGWICK, ss.
Phyllis Buchanan (employee of owner) ~~PHYLIS BUCHANAN~~
of the above-described well, being first duly sworn on oath, says: That I have knowledge of
the facts, statements, and matters herein contained and the log of the above-described well
as filed and that the same are true and correct. So help me God.

(Signature) Phyllis Buchanan
PHYLLIS BUCHANAN (Address)

SUBSCRIBED AND SWORN TO before me this 4th day of June, 1982

Sherry Wayman
Notary Public.

My commission expires

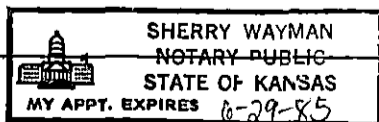

SHERRY WAYMAN

RECEIVED
STATE CORPORATION COMMISSION
JUN 10 1982
CONSERVATION DIVISION
Wichita, Kansas