

RECEIVED

5-17-02
MAY 17 2002

KCC WICHITA

STATE OF KANSAS
KANSAS CORPORATION COMMISSION
CONSERVATION DIVISION
130 South Market - Room 2078
Wichita, Kansas 67202

FORM CP-1 (3/92)

WELL PLUGGING APPLICATION FORM
(PLEASE TYPE FORM and File ONE Copy)

API # 15-129-21441-0001 (Identifier number of this well). This must be listed for wells drilled since 1967; if no API# was issued, indicate spud or completion date.

WELL OPERATOR Nadel and Gussman, L.L.C. KCC LICENSE # 32638
(owner/company name) (operator's)

ADDRESS 3200 First Place Tower CITY Tulsa

STATE Oklahoma ZIP CODE 74103 CONTACT PHONE # (918) 5833333

LEASE Stoops WELL# 1-7 SEC. 7 T. 32 R. 42 (East/West)

C - SW SPOT LOCATION/QQQQ COUNTY Morton

1332 FEET (in exact footage) FROM S (circle one) LINE OF SECTION (NOT Lease Line)

1320 FEET (in exact footage) FROM E/W (circle one) LINE OF SECTION (NOT Lease Line)

Check One: OIL WELL GAS WELL D&A SWD/ENHR WELL DOCKET# _____

CONDUCTOR CASING SIZE N/A SET AT _____ CEMENTED WITH _____ SACKS

SURFACE CASING SIZE 8-5/8 SET AT 1434' CEMENTED WITH 475 SACKS

PRODUCTION CASING SIZE 5-1/2 SET AT 3400' CEMENTED WITH 525 SACKS

LIST (ALL) PERFORATIONS and BRIDGEPLUG SETS: see attached

ELEVATION 3606' T.D. 3400' PBD 2890' ANHYDRITE DEPTH 1417'
(G.L./K.B.) (Stone Corral Formation)

CONDITION OF WELL: GOOD POOR CASING LEAK JUNK IN HOLE

PROPOSED METHOD OF PLUGGING Run tubing to 1440' and circulate cement to surface. Cut off casing 3'
below GL and fill csg/csg annulus w/cement. Weld on I.D. plate and backfill.

(If additional space is needed attach separate page)

IS WELL LOG ATTACHED TO THIS APPLICATION AS REQUIRED? yes IS ACO-1 FILED? yes

If not explain why? _____

PLUGGING OF THIS WELL WILL BE DONE IN ACCORDANCE WITH K.S.A. 55-101 et. seq. AND THE RULES AND REGULATIONS OF THE STATE CORPORATION COMMISSION.

LIST NAME OF COMPANY REPRESENTATIVE AUTHORIZED TO BE IN CHARGE OF PLUGGING OPERATIONS:

John May PHONE# (620) 697-2137

ADDRESS P.O. Box 773 City/State Elkhart, KS 67950

PLUGGING CONTRACTOR Sargent and Horton Plugging, Inc. KCC LICENSE # 31151

ADDRESS Rt. 1 Box 49BA, Tyrone, OK 73951-9731 PHONE # (580) 854-6515
(company name) (contractor's)

PROPOSED DATE AND HOUR OF PLUGGING (If Known?) ASAP

PAYMENT OF THE PLUGGING FEE (K.A.R. 82-3-118) WILL BE GUARANTEED BY OPERATOR OR AGENT

DATE: May 15, 2002 AUTHORIZED OPERATOR/AGENT: James P. [Signature]
(signature)

Original:

Revised: 05/15/02

RECEIVED

MAY 17 2002

KCC WICHITA

Stoops 1-7
Section 7 - 32S - 42W
Morton County, KS

Elevation: 3606' GL

TOC: Surface

CURRENT CONFIGURATION


Tubing:
None

Production Casing:

5-1/2", 14# & 15.5#, K-55 @3400'
W/ 210 sx 3.22 yield, 315 sx 1.42 yield
Circulated 40 bbls to pit.

Surface Casing

8-5/8", 24#, J-55 @ 1434'
w/ 325 sx 3.25 yield, 150 sx 1.34 yield.
Circ 90 sx to pit.

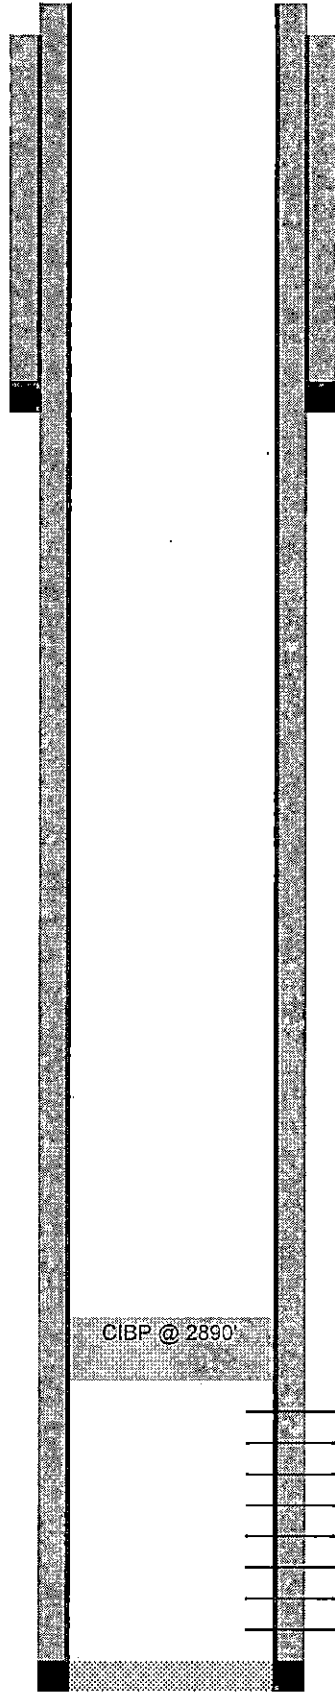

Perfs:
2970-72, 2982-85

2995-3004, 3046-50
3063-69, 3088-93

3154-63, 3170-91
3237-41, 3296-98

jrp

TD@ 3400'



Kansas Corporation Commission

Bill Graves, Governor John Wine, Chair Cynthia L. Claus, Commissioner Brian J. Moline, Commissioner

NOTICE OF RECEIPT OF WELL PLUGGING APPLICATION (CP-1)

Nadel and Gussman, LLC
3200 First Place Tower
Tulsa, OK 74103-4313

May 23, 2002

Re: STOOPS #1-7
API 15-129-21441-00-01
CSW 7-32S-42W, 1320 FSL 1320 FEL
MORTON COUNTY, KANSAS

Dear Operator:

This letter is to notify you that the Conservation Division is in receipt of your plugging proposal, form CP-1, for the above-captioned well.

Your CP-1 has been reviewed by the Conservation Division central office for completeness and to verify license numbers. The plugging proposal will now be forwarded to the district office listed below for review of your proposed method of plugging.

Please contact the district office for approval of your proposed plugging method at least five (5) days before plugging the well, pursuant to K.A.R. 82-3-113 (b). If a workover pit will be used during the plugging of the well it must be permitted. A CDP-1 form must be filed and approved prior to the use of the pit.

The Conservation Division's review of form CP-1, either in the central or district office, does not include an inquiry into well ownership or the filing operator's legal right to plug the well.

This notice in no way constitutes authorization to plug the above-captioned well by persons not having legal rights of ownership or interest in the well. This notice is void after ninety (90) days from the above date.

Sincerely

A handwritten signature in cursive script, appearing to read "David P. Williams".

David P. Williams
Production Supervisor

District: #1
210 E Frontview, Suite A
Dodge City, KS 67801
(316) 225-8888