


STATE OF KANSAS
STATE CORPORATION COMMISSION

Give All Information Completely
Make Required Affidavit
Mail or Deliver Report to:
Conservation Division
State Corporation Commission
800 Bittling Building
Wichita, Kansas

WELL PLUGGING RECORD

NORTH

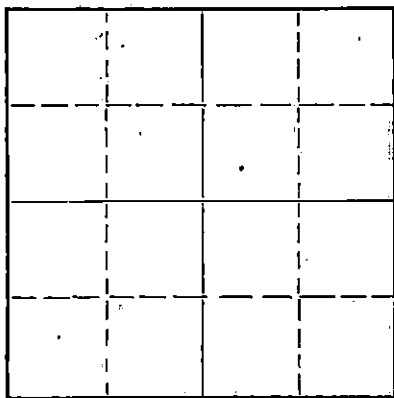

Locate well correctly on above
Section Plat

Meade County, Sec. 17 Twp. 32S Rge. (E) 30(W)
Location as "NE/CNW/SW" or footage from lines C SW SW
Lease Owner E. F. Wakefield & Etal.
Lease Name Baty Well No. 1
Office Address 515 Union Center Bldg., Wichita, Kansas
Character of Well (completed as Oil, Gas or Dry Hole) Gas well
Date well completed 7/12/57 19 57
Application for plugging filed 11/29/57 19 57
Application for plugging approved 19
Plugging commenced 12/2/57 19 57
Plugging completed 12/8/57 19 57
Reason for abandonment of well or producing formation not economical

If a producing well is abandoned, date of last production October 19 57
Was permission obtained from the Conservation Division or its agents before plugging was commenced? yes

Name of Conservation Agent who supervised plugging of this well M. A. Rives
Producing formation Depth to top Bottom Total Depth of Well 5722 Feet
Show depth and thickness of all water, oil and gas formations.

OIL, GAS OR WATER RECORDS

CASING RECORD

FORMATION	CONTENT	FROM	TO	SIZE	PUT IN	PULLED OUT
				8 5/8"	1580	none
				5 1/2"	5721	2682

Describe in detail the manner in which the well was plugged, indicating where the mud fluid was placed and the method or methods used in introducing it into the hole. If cement or other plugs were used, state the character of same and depth placed, from feet to feet for each plug set.

Squeezed 20 sacks cement into Morrow Sand, left 15 sacks or 120 ft. in 5 1/2 pipes, pulled pipe. Pumped 25 sacks of gel mud with Halliburton 8 5/8 plug on top, then 175 sacks cement. Cement from 570 ft. to top of surface pipe.

RECEIVED
CORPORATION COMMISSION

PLUGGING
FILED SEC 17 T 32 R 30 W
BOOK PAGE 64 LINE 19

DEC 26 1957
12-26-1957
DIVISION

Name of Plugging Contractor Hall & Prather
Address Box 131, Great Bend, Kansas

STATE OF Kansas COUNTY OF Sedgwick, ss.
Cecil A. Prather (employee of owner) or (owner or operator) of the above-described well, being first duly sworn on oath, says: That I have knowledge of the facts, statements, and matters herein contained and the log of the above-described well as filed and that the same are true and correct. So help me God.

(Signature) Cecil A. Prather
Box # 131, Great Bend, Kansas (Address)

SUBSCRIBED AND SWORN to before me this 23rd day of December, 19 57

My commission expires July 26, 1958 C. A. Snow Notary Public.

HALL & PRATHER
BOX 131 Ph. GL3-7738 Mobile ZF39553
GREAT BEND, KANSAS

Plugging License #153

LEASE: Baty #1
 OWNER: Coop. Refin. Assoc & Earl F. Wakefield
 CONTRACTOR: Earl F. Wakefield
 COMM: 6-5-56 COMP: 7-12-56

15-119-00048-0001

LOCATION: C SW/4 SW/4
 Sec 17-32S-30W
 Meade Co., Kansas
 CASING: 8 5/8" Set @1580'
 5 1/2" Set @5721

Elevation 1782 K. B.

Gyp & Sand	131
Sand & Gravel	490
Red Bed	515
Red Shale	990
Red Bed	1070
Shale & Shells	1170
Sand	1300
Shale & Shells	1526
Anhydrite	1580
Anhydrite & Red Shale	1635
Red Shale	2015
Shale & Lime	2180
Shale & Shells	2510
Shale & Lime	2655
Shale & Shells	2755
Shale	2795
Shale & Lime	3060
Lime	3177
Lime & Shale	3375
Lime	3490
Lime & Shale	3625
Chalky Lime	3725
Lime	3810
Lime & Shale	3812
Lime	3845
Chalky Lime	3875
Lime	3935
Lime & Shale	4383
Lime, Broken	4455
Lime & Shale	4535
Lime	4620
Lime & Shale	4710
Lime	5045
Lime & Shale	5145
Lime	5225
Lime & Shale	5365
Lime	5459
Lime & Shale	5490
Lime (Cherty)	5508
Lime & Shale	5593
Lime	5610
Sand (Morrow)	5636 } 24'
Sandy Lime	5670
Lime	5722
T. B. D.	5722

RECEIVED
 STATE CORPORATION COMMISSION

NOV 29 1957

CONSERVATION DIVISION
 Wichita, Kansas

STATE OF KANSAS)
) SS
 COUNTY OF SEDGWICK)

I hereby certify that the above is a true and correct copy of the log of the Baty #1 well located C SW/4 SW/4 17-32S-30W, Meade County, Kansas

Earl F. Wakefield

and sworn to before me this 24 day of July 1956

My Commission Expires 7-26-59

PLUGGING
 FILE SEC. 17 T. 32 R. 30W
 BOOK PAGE 64 LINE 19