


STATE OF KANSAS
STATE CORPORATION COMMISSION
Give All Information Completely
Make Required Affidavit
Mail or Deliver Report to:
Conservation Division
State Corporation Commission
212 North Market, Insurance Bldg.
Wichita, Kansas

WELL PLUGGING RECORD

Meade County, Sec. 31 Twp. 32S Rge. (E) 28 (W)

Location as "NE/CNW/SW" or footage from lines C SW SW
Lease Owner Sunray Mid-Continent Oil Company
Lease Name Ada Hallock Well No. 1
Office Address 321 West Douglas - Wichita, Kansas
Character of Well (completed as Oil, Gas or Dry Hole) Dry Hole
Date well completed May 30 19 60
Application for plugging filed May 31 19 60
Application for plugging approved June 1 19 60
Plugging commenced June 1 19 60
Plugging completed June 3 19 60
Reason for abandonment of well or producing formation Dry hole

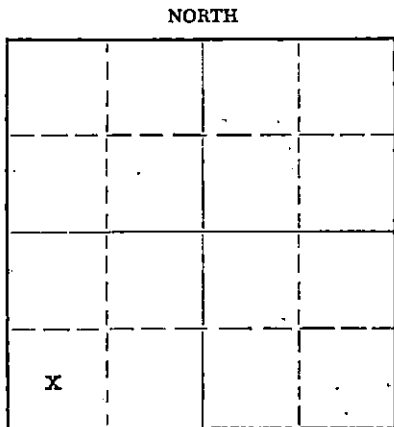

Locate well correctly on above Section Plat

If a producing well is abandoned, date of last production -- 19
Was permission obtained from the Conservation Division or its agents before plugging was commenced? Yes

Name of Conservation Agent who supervised plugging of this well W. L. LaKamp
Producing formation None Depth to top Bottom Total Depth of Well 5730 Feet
Show depth and thickness of all water, oil and gas formations.

OIL, GAS OR WATER RECORDS

CASING RECORD

FORMATION	CONTENT	FROM	TO	SIZE	PUT IN	PULLED OUT
Morrow Sand	Dry	5543	5578	8-5/8"	1548'	0

Describe in detail the manner in which the well was plugged, indicating where the mud fluid was placed and the method or methods used in introducing it into the hole. If cement or other plugs were used, state the character of same and depth placed, from feet to feet for each plug set.

Filled hole with drilling mud until settling stopped. Ten sack cement plug was placed at the surface and a steel plate welded over the 8-5/8" surface casing.

RECEIVED
STATE CORPORATION COMMISSION

JUN 6 1960

CONSERVATION DIVISION
Wichita, Kansas

(If additional description is necessary, use BACK of this sheet)

Name of Plugging Contractor Stickle Drilling Company
Address Tulsa, Oklahoma

STATE OF Kansas, COUNTY OF Sedgwick, ss.

Nash A. Gough (employee of owner) or owner or operator of the above-described well, being first duly sworn on oath, says: That I have knowledge of the facts, statements, and matters herein contained and the log of the above-described well as filed and that the same are true and correct. So help me God.

(Signature) Nash A. Gough
321 West Douglas - Wichita, Kansas
(Address)

SUBSCRIBED AND SWORN to before me this 3 day of June, 19 60

My commission expires July 13, 1963

[Signature] Notary Public.

Sunray Mid-Centinent Oil Company
Tulsa, Oklahoma

Tulsa, Oklahoma
May 31, 1960

Contractors Stickle Drilling Company
Date Commenced: May 8, 1960
Date Completed: May 29, 1960

Ada Hallock No. 1
C SW SW 31-32S-28W
Meade County, Kansas

Drillers Log

Depth Figures Indicate Base of Formations

Sand	205
Sand and clay	250
Sand and Shale	350
Red Bed	600
Shale and Shells	980
Sandy shale	1085
Shale and shells	1408
Anhydrite and shale	1455
Shale and shells	2340
Shale and lime	2591
Lm. sh. & sd. streaks	2760
Lime and shale	3008
Shale & shells	3170
Lime	3670
Lime and shale	3796
Shale	3930
Lime and shale	4200
Shale and lime	4415
Lime and shale	4530
Shale and shells	4590
Shale and lime	4684
Lime	4721
Lime and shale	4837
Lime	5277
Lime and shale	5340
Lime	5537
Shale and sand	5549
Sand and shale	5555
Lime and shale	5595
Lime	5660
Lime and shale	5690
Shale and lime	5730 TD

RECEIVED

STATE CORPORATION COMMISSION

JUN 6 1960

CONSERVATION DIVISION
Wichita Kansas

I, Fred E. Stickle, hereby certify the above to be a true and complete Drillers Log of Sunray Mid-Centinent Oil Company's Ada Hallock No. 1, C SW SW Section 31-32S-28W, Meade County, Kansas.

Fred E. Stickle

Notary Public

My commission expires March 24, 1964