

STATE OF KANSAS
STATE CORPORATION COMMISSION

Form CP-4

Give All Information Completely
Make Required Affidavit
Mail or Deliver Report to:
Conservation Division
State Corporation Commission
212 No. Market
Wichita, Kansas

WELL PLUGGING RECORD

Seward County, Sec. 15 Twp. 34S Rge. 31W (E) (W)

Location as "NE/CNW/SW" or footage from lines C-SW-NE

Lease Owner Cayman Corporation, Palos Verdes Peninsula, California

Lease Name Black Well No. 1

Office Address 27608 Silver Spur Road

Character of Well (completed as Oil, Gas or Dry Hole) Dry Hole

Date well completed October 5, 19 67

Application for plugging filed October 5, 19 67

Application for plugging approved October 5, 19 67

Plugging commenced October 5, 19 67


Plugging completed October 5, 19 67

Reason for abandonment of well or producing formation

Dry Hole

If a producing well is abandoned, date of last production 19

Was permission obtained from the Conservation Division or its agents before plugging was commenced? Yes

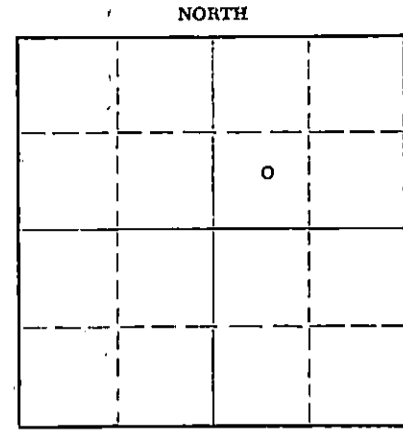

Locate well correctly on above Section Plat

Name of Conservation Agent who supervised plugging of this well Eddie Eves

Producing formation Depth to top Bottom Total Depth of Well 5947 Feet R.T.D.

Show depth and thickness of all water, oil and gas formations.

OIL, GAS OR WATER RECORDS

CASING RECORD

FORMATION	CONTENT	FROM	TO	SIZE	PUT IN	PULLED OUT
		0	1346'	8 5/8"	9-22-67	

Describe in detail the manner in which the well was plugged, indicating where the mud fluid was placed and the method or methods used in introducing it into the hole. If cement or other plugs were used, state the character of same and depth placed, from feet to feet for each plug set.

700' - 600' w/35 sacks 50-50 Poz
Plug 35' - 0' w/15 sacks 50-50 Poz
Also plugged rat hole & mouse hole

RECEIVED
STATE CORPORATION COMMISSION
OCT 13 1967

CONSERVATION DIVISION
WICHITA, KANSAS

(If additional description is necessary, use BACK of this sheet)

Name of Plugging Contractor Zenith Drilling Corporation, Inc.
Address Suite 737 - 300 West Douglas, Wichita, Kansas

STATE OF Kansas, COUNTY OF Sedgwick, ss.
C. Robert Buford (employee of owner) or (owner or operator) of the above-described well, being first duly sworn on oath, says: That I have knowledge of the facts, statements, and matters herein contained and the log of the above-described well as filed and that the same are true and correct. So help me God.

(Signature) C. Robert Buford
Suite 737-300 West Douglas, Wichita, Kansas (Address)


Subscribed and sworn to before me this 6th day of October, 1967.
My commission expires August 15, 1971.



Myrna D. Murphy
Notary Public.

WELL LOG

COMPANY **Cayman Corporation** SEC. **15-T34S-R31W**
 27608 Silver Spur Road, Palos Verdes Peninsula,
 FARM NO. **1** Calif. LOC. **C-SW-NE**
BLACK
 TOTAL DEPTH **5947' R.T.D.** COUNTY **Seward**
5948' L.T.D.
 COMM. **9-21-67** COMP. **10-5-67**
 CONTRACTOR **Zenith Drilling Corp., Inc.**

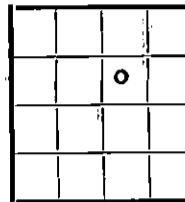

CASING
 8 5/8" @1346' w/landing jt., cemented
 w/500 sx. light wt. 4% gel 2% CaCl,
 & 100 sx. Class A 2% CaCl

ELEVATION

PRODUCTION **D & A**

FIGURES INDICATE BOTTOM OF FORMATIONS

645'	Sand, Blue Shale, Red Bed
1346'	Red Bed, Sand, Anhydrite
1515'	Anhydrite, Red Bed
2075'	Red Bed, Shale
2295'	Red Bed, Shale, Lime
2615'	Shale & Lime
3036'	Lime & Shale
3518'	Shale & Lime
3715'	Lime & Shale
4168'	Shale
4472'	Lime
4755'	Lime & Shale
5380'	Lime
5469'	Lime & Shale
5615'	Lime, Shale & Sand
5685'	Sand & Lime
5947' T.D.	Lime & Shale

RECEIVED
STATE CORPORATION COMMISSION

OCT 13 1967

CONSERVATION DIVISION
Wichita, Kansas

State of Sedgwick }
 County of Kansas } SS

I, C. Robert Buford, President of Zenith Drilling Corporation, Inc.

upon oath state the above and foregoing is a true and correct copy of the log of the Black #1 well.

C Robert Buford

Subscribed and sworn to before me this 6 day of October, 1967.

My Commission Expires: August 15, 1971.

Myrna S Murphy
 NOTARY PUBLIC

