


STATE OF KANSAS  
STATE CORPORATION COMMISSION

WELL PLUGGING RECORD

Give All Information Completely  
Make Required Affidavit  
Mail or Deliver Report to:  
Conservation Division  
State Corporation Commission  
211 No. Broadway  
Wichita, Kansas

Meade County, Sec. 24 Twp. 34S Rge. (E) 30 (W)  
Location as "NE/CNW/SW" or footage from lines NE SW SW  
Lease Owner Thomas & Brewer  
Lease Name A. W. Adams "B" Well No. 3  
Office Address \_\_\_\_\_  
Character of Well (completed as Oil, Gas or Dry Hole) Dry  
Date well completed 3-29-60 19 60  
Application for plugging filed 3-29 19 60  
Application for plugging approved 3-29 19 60  
Plugging commenced 4-1 19 60  
Plugging completed 4-1 19 60  
Reason for abandonment of well or producing formation Dry hole

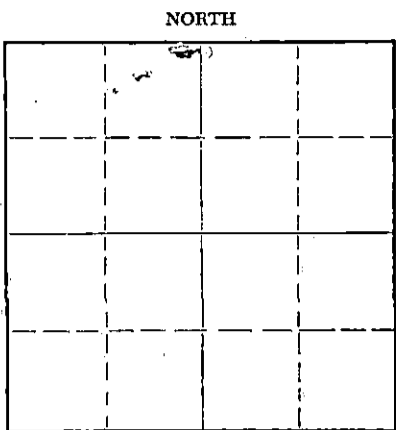

Locate well correctly on above Section Flat

If a producing well is abandoned, date of last production 19 \_\_\_\_\_  
Was permission obtained from the Conservation Division or its agents before plugging was commenced? \_\_\_\_\_

Name of Conservation Agent who supervised plugging of this well W.F. Lackamp  
Producing formation \_\_\_\_\_ Depth to top \_\_\_\_\_ Bottom \_\_\_\_\_ Total Depth of Well \_\_\_\_\_ Feet  
Show depth and thickness of all water, oil and gas formations.

OIL, GAS OR WATER RECORDS				CASING RECORD		
FORMATION	CONTENT	FROM	TO	SIZE	PUT IN	PULLED OUT

Describe in detail the manner in which the well was plugged, indicating where the mud fluid was placed and the method or methods used in introducing it into the hole. If cement or other plugs were used, state the character of same and depth placed, from \_\_\_\_\_ feet to \_\_\_\_\_ feet for each plug set.

Filled to 550' with heavy mud. Plug @ 550' with 1/4 sack hulls, 20 sacks cement thru drill pipe. Plug @ 40' with 1/4 sack hulls, filled to cellar with 15 sacks cement.

RECEIVED  
STATE CORPORATION COMMISSION

APR 12 1960 4-12-1960

CONSERVATION DIVISION  
Wichita, Kansas

Name of Plugging Contractor Bennett & Roberts  
Address Russell, Kansas

STATE OF Kansas COUNTY OF Leward, ss.  
Allen F. Thomas (employee of owner) or (owner or operator) of the above-described well, being first duly sworn on oath, says: That I have knowledge of the facts, statements, and matters herein contained and the log of the above-described well as filed and that the same are true and correct. So help me God.

(Signature) [Signature]  
Box 985 - Liberal, Kansas  
(Address)

SUBSCRIBED AND SWORN TO before me this 11th day of April, 19 60  
Nov. 5, 1962  
Maudine Keating  
Notary Public.

My commission expires \_\_\_\_\_

THOMAS & BREWER  
ADAMS "B" #3

NE SW SW Sec. 24-34-30  
Meade County, Kansas

RTD 6012  
Commenced 3/6/60  
Completed 3/20/60

CONTRACTOR: Bennett & Roberts Drilling Co.

Set 8 5/8" @ 1482' w/650 ex amt.

Surface Soil & Clay	78'
Clay	125'
Sand	290'
Clay	390'
Sand & Clay	620'
Red Bed	1370'
Shale & Shells	1473'
Anhydrite	1493'
Red Bed & Anhydrite	1540'
Red Bed & Shale	1900'
Shale & Shells	2138'
Shale & Lime	2332'
Lime & anhydrite streaks	2468'
Lime	2610'
Anhydrite & Lime	2625'
Lime & Shale	2705'
Lime	3322'
Lime w/Chalk streaks	3392'
Chalky Lime	3570'
Lime	3617'
Lime & Shale	3795'
Lime	3837'
Shale & Lime	4020'
Shale	4185'
Shale & Lime	4821'
Lime	5733'
Lime & Shale	5788'
Lime	5878'
Lime & Shale	6002'
Lime	6012'

RECEIVED  
STATE CORPORATION COMMISSION  
APR 12 1960  
CONSERVATION DIVISION  
Wichita, Kansas

STATE OF KANSAS )  
RUSSELL COUNTY ) ss.

I hereby certify that the above information is correct to the best of my knowledge.

BENNETT & ROBERTS DRILLING CO.

By *Jessie Lee Marshall*

Subscribed and sworn to before me this 1st day of April, 1960.

*Clara Linn*  
Notary Public

My Commission Expires 6/17/62