


15-119-10337-0000

STATE OF KANSAS
STATE CORPORATION COMMISSION

Give All Information Completely
Make Required Affidavit
Mail or Deliver Report to:
Conservation Division
State Corporation Commission
211 No. Broadway
Wichita, Kansas

WELL PLUGGING RECORD

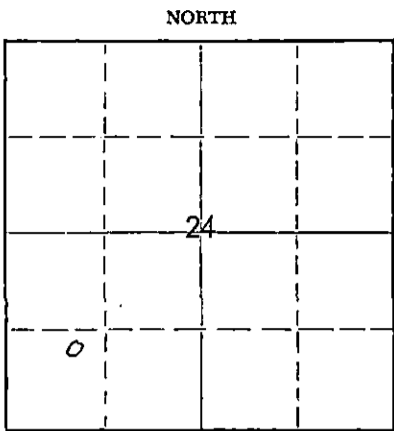

Locate well correctly on above
Section Plat

Meade County. Sec. 24 Twp. 34S Rge. (E) 30 (W) NW NE SW

Location as "NE/CNW%SW%" or footage from lines
Lease Owner Thomas & Brewer
Lease Name A.W. Adams "B" Well No. 4
Office Address Drawer 1248, Liberal, Kansas
Character of Well (completed as Oil, Gas or Dry Hole) Dry Hole
Date well completed 6-27 19 61
Application for plugging filed 6-27 19 61
Application for plugging approved 6-27 19 61
Plugging commenced 6-28 19 61
Plugging completed 6-28 19 61
Reason for abandonment of well or producing formation Dry Hole

If a producing well is abandoned, date of last production 19
Was permission obtained from the Conservation Division or its agents before plugging was commenced? Yes

Name of Conservation Agent who supervised plugging of this well Mr. Broadfoot
Producing formation _____ Depth to top _____ Bottom _____ Total Depth of Well _____ Feet
Show depth and thickness of all water, oil and gas formations.

OIL, GAS OR WATER RECORDS

CASING RECORD

FORMATION	CONTENT	FROM	TO	SIZE	PUT IN	PULLED OUT
Surface Water	Sand	Fresh Water	300	350		

Describe in detail the manner in which the well was plugged, indicating where the mud fluid was placed and the method or methods used in introducing it into the hole. If cement or other plugs were used, state the character of same and depth placed, from _____ feet to _____ feet for each plug set.

Filled to 550' with heavy mud.
Plug @ 550' with 1/4 sack hulls topped with 20 sacks cement thru drill pipe. Heavy mud to 40'. Plug @ 40' with 1/4 sack hulls, filled to cellar with 20 sacks cement.

RECEIVED
STATE CORPORATION COMMISSION

JUL 7 1961

CONSERVATION DIVISION
Wichita, Kansas

RECEIVED
STATE CORPORATION COMMISSION

JUL 7 1961

CONSERVATION DIVISION
Wichita, Kansas

(If additional description is necessary, use BACK of this sheet)

Name of Plugging Contractor Bennett & Roberts Drilling Co.
Address Russell, Kansas

STATE OF Kansas, COUNTY OF Seward, ss.
Glenn E. Thomas (employee of owner) or (owner or operator) of the above-described well, being first duly sworn on oath, says: That I have knowledge of the facts, statements, and matters herein contained and the log of the above-described well as filed and that the same are true and correct. So help me God.

(Signature) Glenn E. Thomas
Drawer 1248, Liberal, Kansas
(Address)

SUBSCRIBED AND SWORN TO before me this 5th day of July, 1961

My commission expires 11-5-62

Marlene Keating
Notary Public.



R

THOMAS & BREWER
ADAMS B-4

SW NE NW Section 24-34-30N
Meade County, Kansas

RTD 6100

CONTRACTOR: Bennett & Roberts Drilling Co.

Commenced 6/8/61
Completed 6/29/61

8 5/8" Csg. Set @ 1494' w/650 sx.

Sand	30
Surface Soil & Sand	220
Sand	336
Red Bed & Sand	516
Sand	607
Shale & Sand	845
Red Bed	973
Sand	1000
Red Bed & Sand	1484
Anhydrite	1506
Red Bed & Shale	1925
Shale & Anhydrite Streaks	2260
Shale & Lime	2605
Lime, Shale & Anhydrite	2715
Lime & Shale	2879
Lime w/Chalk Streaks	2985
Lime & Chalk Streaks	3073
Chalky Lime	3164
Lime	3255
Lime & Chalk Streaks	3356
Lime & Chalk	3675
Lime	3778
Lime & Shale Streaks	3870
Shale	4050
Lime & Shale	4283
Shale	4353
Lime & Shale	4643
Lime	5624
Lime & Shale	5775
Lime	5825
Lime & Shale	5946
Lime & Sand	5984
Lime & Shale	5995
Lime	6100

RECEIVED
STATE CORPORATION COMMISSION
OCT 11 1961
CONSERVATION DIVISION
Wichita, Kansas

STATE OF KANSAS)
RUSSELL COUNTY) SS.

I hereby certify that the above information is correct to the best of my knowledge.

BENNETT & ROBERTS DRILLING COMPANY

By Mildred Roberts

Subscribed and sworn to before me this 30th day of June, 1961

Clara L. Linn
Notary Public

My Commission Expires 6/17/62