


STATE OF KANSAS
STATE CORPORATION COMMISSION

Form CP-4

Give All Information Completely
Make Required Affidavit
Mail or Deliver Report to:
Conservation Division
State Corporation Commission
P. O. Box 17027
Wichita, Kansas 67217
NORTH

WELL PLUGGING RECORD

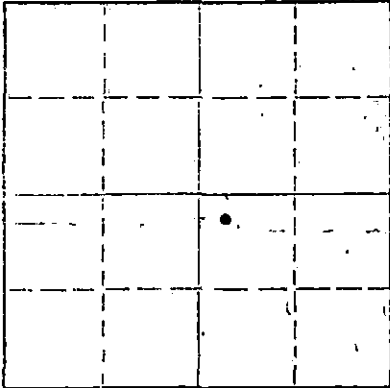

Locate well correctly on above
Section Plat

Meade County, Sec. 24 Twp. 34S Rge. 30W (E) (W)
Location as "NE/CNW/SW" or footage from lines 330' FWL & 330' FNL of SE/4
Lease Owner Cotton Petroleum Company
Lease Name Adams "C" Well No. 1
Office Address 2121 S. Columbia, Suite 600, Tulsa, Oklahoma 74114
Character of Well (completed as Oil, Gas or Dry Hole) Dry hole
Date well completed September 18 19 72
Application for plugging filed September 18 19 72
Application for plugging approved September 20 (verbal 9/21/72) 19 72
Plugging commenced September 19 19 72
Plugging completed September 19 19 72
Reason for abandonment of well or producing formation No commercial shows of
oil or gas
If a producing well is abandoned, date of last production 19
Was permission obtained from the Conservation Division or its agents before plugging was com-
menced? Yes

Name of Conservation Agent who supervised plugging of this well Mr. E. Eves
Producing formation _____ Depth to top _____ Bottom _____ Total Depth of Well 3750 Feet
Show depth and thickness of all water, oil and gas formations.

OIL, GAS OR WATER RECORDS

CASING RECORD

FORMATION	CONTENT	FROM	TO	SIZE	PUT IN	PULLED OUT
Herington	Water	2697		8-5/8	661	
Krider	Water	2734		4-1/2		2,200
Winfred	Water	2784			3750	
Upper Ft. Riley	Water	2850				
Lower Ft. Riley	Water	2936				
Florence Flint	Water	2996				
Wreford	Water	3046				
Council Grove Pay	Water	3156				

Describe in detail the manner in which the well was plugged, indicating where the mud fluid was placed and the method or methods used in introducing it into the hole. If cement or other plugs were used, state the character of same and depth placed, from _____ feet to _____ feet for each plug set.

Pumped 20 sx. common cement from 2650' to 3050'. Spotted 35 sx. plug from 45' to 0'.

RECEIVED
STATE CORPORATION COMMISSION
SEP 25 1972
CONSERVATION DIVISION
Wichita, Kansas

Name of Plugging Contractor Byron Jackson, Inc. (If additional description is necessary, use BACK of this sheet)
Address Perryton, Texas

STATE OF Oklahoma COUNTY OF Tulsa, ss.
J. L. Burkhart (employee of owner) or (owner or operator) of the above-described

well, being first duly sworn on oath, says: That I have knowledge of the facts, statements, and matters herein contained and the log of the above-described well as filed and that the same are true and correct. So help me God.

(Signature) *J. L. Burkhart*
2121 S. Columbia, Tulsa, Oklahoma
(Address)

SUBSCRIBED AND SWORN to before me this 22nd day of September, 19 72

My commission expires *October 22, 1973*
Notary Public

WELL LOG

Company Cotton Petroleum Co.

Sec.24 T. 34 R.30

Contractor Leben Drilling, Inc.

Loc.

Farm Adams C-1

County Meade Co. KS


Total Depth 3750'

Casing 8 5/8"

Commenced 8-30-72

Production 4 1/2"

Completed 9-6-72

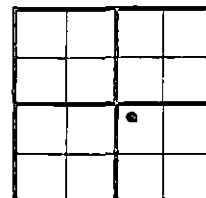

Figures Indicate Bottom of Formations

0	-	70	Surface
70	-	576	Sand-Red Bed
576	-	663	Red Bed-Shale
663	-	1445	Shale-Anhy-Red Bed-Sand
1445	-	1995	Shale-Shells
1995	-	2515	Shale-Anhydrate
2515	-	3750	Lime-Shale

RECEIVED
STATE CORPORATION COMMISSION
SEP 25 1972
CONSERVATION DIVISION
Wichita, Kansas

State of Oklahoma
County of Oklahoma

SS

I, Leslie Kite of Leben Drilling, Inc., upon oath state that the above and foregoing is a true and correct copy of the log of the Adams C-1 Well.

Leslie Kite

Subscribed and sworn to before me this 13th day of August, 1972

My Commission Expires: 5/23/76
Brenda Kay Zwick