


STATE OF KANSAS  
STATE CORPORATION COMMISSION

WELL PLUGGING RECORD

Give All Information Completely  
Make Required Affidavit  
Mail or Deliver Report to  
Conservation Division  
State Corporation Comm.  
245 North Water  
Wichita, KS 67202

Location as Sumner County, Sec. 7 Twp. 33S Rge. 1 xx/W  
Location as "NE/CNW $\frac{1}{4}$ SW $\frac{1}{4}$ " or footage from lines C NW SE SE  
Lease Owner Hawkins Oil & Gas, Inc.  
Lease Name Sukovaty Well No. 1-7  
Office Address 320 S. Boston, Suite 701, Tulsa, Ok  
Character of Well (Completed as Oil, Gas or Dry Hole) 74103

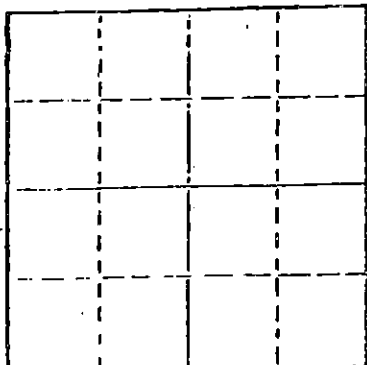

Locate well correctly on above  
Section Plot

Date Well completed 2-20 19 81  
Application for plugging filed 2-20 19 81  
Application for plugging approved 2-20 19 81  
Plugging commenced 2-20 19 81  
Plugging completed 2-20 19 81

Reason for abandonment of well or producing formation  
no commercial quantity of oil or gas encountered  
If a producing well is abandoned, date of last production  
19

Was permission obtained from the Conservation Division or  
its agents before plugging was commenced? yes

Name of Conservation Agent who supervised plugging of this well Carl Barnett  
Producing formation \_\_\_\_\_ Depth to top \_\_\_\_\_ Bottom \_\_\_\_\_ Total Depth of Well 4287  
Show depth and thickness of all water, oil and gas formations.

OIL, GAS OR WATER RECORDS

CASING RECORD

FORMATION	CONTENT	FROM	TO	SIZE	PUT IN	PULLED OUT
surface hole	shale	surf	255	8-5/8	252	none

Describe in detail the manner in which the well was plugged, indicating where the mud fluid  
was placed and the method or methods used in introducing it into the hold. If cement or other  
plugs were used, state the character of same and depth placed, from \_\_\_\_\_ feet to  
\_\_\_\_\_ feet for each plug set.

Fluid to 265', plug, 30 sx  
Fluid to 40', plug, 10 sx  
Rat hole 3 sx

MAR - 2 1981  
FILED  
STATE CORPORATION COMMISSION  
Wichita, Kansas

(If additional description is necessary, use BACK of this sheet)

Name of Plugging Contractor D.N.B. DRILLING, INC.  
515 R. H. Garvey Building  
Wichita, Kansas 67202

3-2-1981

STATE OF Kansas COUNTY OF Sedgwick, ss.  
James L. Donelson, Jr. (employee of owner) or (owner or operator)  
of the above-described well, being first duly sworn on oath, says: That I have knowledge of  
the facts, statements, and matters herein contained and the log of the above-described well  
as filed and that the same are true and correct. So help me God.

(Signature) James L. Donelson Jr.  
515 R.H. Garvey Bldg. Wichita, Ks. 67202  
(Address)

SUBSCRIBED AND SWORN TO before me this 25th day of February, 19 81

My commission expires April 30, 1983

Dorothy L. Schmidt  
Dorothy L. Schmidt Notary Public.

DOROTHY L. SCHMIDT  
STATE NOTARY PUBLIC  
Sedgwick County, Kansas  
My Appt. Exp. April 30, 1983

DRILLER'S LOG

HAWKINS OIL & GAS, INC.  
No. 1-7 Sukovaty  
C NW SE SE  
Sec 7-33S-1W  
Sumner Co., Ks.

Commenced: 2-9-81  
Completed: 2-20-81

Surface Casing: 252' of 8-5/8"  
cemented w/175 sx

FORMATION

DEPTH

Surface Hole	0 - 255
Sand & Shale	255 - 751
Sand, Shale & Lime	751 - 975
Shale & Lime	975 - 3155
Shale	3155 - 3235
Lime	3235 - 3300
Lime & Shale	3300 - 3421
Lime	3421 - 4215
Shale	4215 - 4286
Sand	4286 - 4287 RTD

I do hereby certify that the foregoing statements are true and correct to the best of my knowledge and belief.

D N B DRILLING, INC.  
*James L. Donelson, Jr.*  
James L. Donelson, Jr.

STATE OF KANSAS: ss:

Subscribed and sworn to before me this 23rd day of February, 1981.

*Dorothy L. Schmidt*  
Dorothy L. Schmidt, Notary Public

DOROTHY L. SCHMIDT  
STATE NOTARY PUBLIC  
Sedgwick County, Kansas  
My Appt. Exp. April 30, 1983