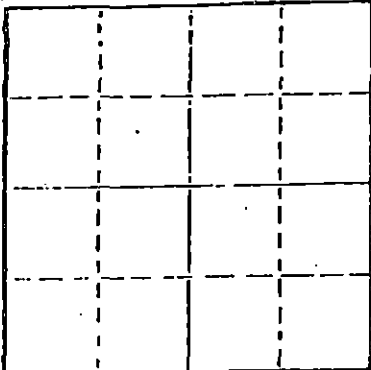


STATE OF KANSAS
STATE CORPORATION COMMISSION

WELL PLUGGING RECORD

Give All Information Completely
Make Required Affidavit
Mail or Deliver Report to
Conservation Division
State Corporation Comm.
245 North Water
Wichita, KS 67202

Locate well correctly on above
Section PlotSumner County. Sec. 7 Twp. 33 Rge. 1 E/W
Location as "NE/CNW1SW1" or footage from lines
NE SE SELease Owner National Oil Co.
Lease Name Sukovaty #1 Well No. _____
Office Address Wichita, Kansas
Character of Well (Completed as Oil, Gas or Dry Hole) _____Date Well completed 19____
Application for plugging filed 19____
Application for plugging approved 19____
Plugging commenced 12/30/78 19____
Plugging completed 1/5/79 19____
Reason for abandonment of well or producing formation
depleted.If a producing well is abandoned, date of last production
19____Was permission obtained from the Conservation Division or
its agents before plugging was commenced? yesName of Conservation Agent who supervised plugging of this well Barnett
Producing formation _____ Depth to top _____ Bottom _____ Total Depth of Well 4295
Show depth and thickness of all water, oil and gas formations.

OIL, GAS OR WATER RECORDS

CASING RECORD

FORMATION	CONTENT	FROM	TO	SIZE	PUT IN	PULLED OUT
				8-5/8	413	none
				5 1/2"	4293	3509

Describe in detail the manner in which the well was plugged, indicating where the mud fluid
was placed and the method or methods used in introducing it into the hold. If cement or other
plugs were used, state the character of same and depth placed, from _____ feet to
_____ feet for each plug set.

Sanded to 4275' and ran 5 sacks cement. Shot pipe at 3500', pulled 8 1/2 joints.
Squeezed hole with 5 sacks hulls, 20 sacks gel, released plug and displaced
with 130 sacks 50/50 posmix, 2% gel.

PLUGGING COMPLETE.


RECEIVED
STATE CORPORATION COMMISSION

JAN 15 1979

CONSERVATION DIVISION
Wichita, Kansas(If additional description is necessary, use BACK of this sheet)
Name of Plugging Contractor KELSO CASING PULLING
CHASE, KANSASSTATE OF KANSAS COUNTY OF RICE, ss. 1-15-1979
R. DARRELL KELSO (employee of owner) or (owner or operator)
of the above-described well, being first duly sworn on oath, says: That I have knowledge of
the facts, statements, and matters herein contained and the log of the above-described well
as filed and that the same are true and correct. So help me God.(Signature) R. Darrell Kelso
CHASE, KANSAS
(Address)

SUBSCRIBED AND SWORN TO before me this 11th day of Jan., 19 79

My commission expires

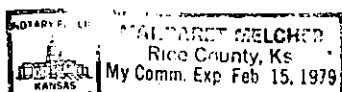Margaret Melcher
Notary Public.

DRILLERS' LOG

NATIONAL OIL COMPANY
 No. 1 Sukovaty
 NE SE SE Sec. 7-33S-1W
 Sumner Co., Kansas

Commenced: 7-11-77
 Completed: 7-23-77

Surface Casing: 410' of 8-5/8"
 cemented w/175 sx common, 2% gel,
 3 % cc. 7-11-77

FORMATIONDEPTH

Surface Hole	0 - 413
Shale	413 - 1459
Shale & Lime	1459 - 2530
Lime & Shale	2530 - 2740
Shale & Lime, Sand	2740 - 2920
Lime & Shale	2920 - 3590
Lime	3590 - 4246
Lime & Shale	4246 - 4285
Lime	4285 - 4293 RTD

RECEIVED
 STATE CORPORATION COMMISSION

JUL 28 1978

CONSERVATION DIVISION
 Wichita, Kansas

I do hereby certify that the foregoing statements are true and correct
 to the best of my knowledge and belief.

D N B DRILLING, INC.

Ella Priess

Ella Priess

STATE OF KANSAS: ss:

Subscribed and sworn to before me this 27th day of July, 1977.

Dorothy L. Schmidt

Dorothy L. Schmidt, Notary Public

DOROTHY L. SCHMIDT
 STATE NOTARY PUBLIC
 Sedgwick County, Kansas
 My Appt. Exp. April 30, 1979

REC'D JUL 28 1977