

15-129-10153-0000

STATE OF KANSAS
STATE CORPORATION COMMISSION

Form CP-4

WELL PLUGGING RECORD

All Information Completely
Required Affidavit
or Deliver Report to:
Conservation Division
State Corporation Commission
211 No. Broadway
Wichita, Kansas

Morton County, Sec. 36 Twp. 32S Rge. 42W (#) (W)

Location as "NE/CNW/SW" or footage from lines. NE - NE

Lease Owner Shenandoah Oil Corporation

Lease Name Grace Ricord Well No. 1

Office Address 608 Mutual Savings Bldg., Fort Worth, Texas

Character of Well (completed as Oil, Gas or Dry Hole) Dry hole

Date well completed October 28 19 65

Application for plugging filed November 2 19 65

Application for plugging approved verbal approval October 28 19 65 r


Plugging commenced October 28 19 65

Plugging completed October 28 19 65

Reason for abandonment of well or producing formation Non-commercial

If a producing well is abandoned, date of last production 19

Was permission obtained from the Conservation Division or its agents before plugging was commenced? Yes

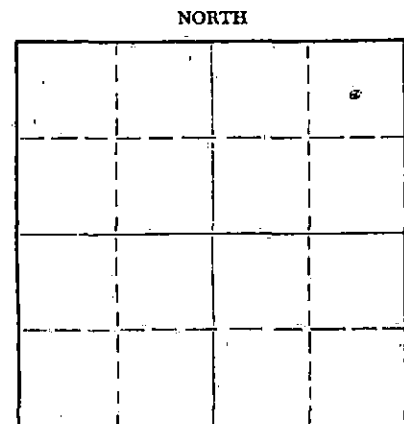

Locate well correctly on above
Section Plat.

Name of Conservation Agent who supervised plugging of this well Hugh E. Scott

Producing formation Dry hole Depth to top Bottom Total Depth of Well 5600 Feet

Show depth and thickness of all water, oil and gas formations.

OIL, GAS OR WATER RECORDS

CASING RECORD

FORMATION	CONTENT	FROM	TO	SIZE	PUT IN	PULLED OUT
				8-5/8	-1472'	None

Describe in detail the manner in which the well was plugged, indicating where the mud fluid was placed and the method or methods used in introducing it into the hole. If cement or other plugs were used, state the character of same and depth placed, from feet to feet for each plug set.

Hole filled with heavy mud. Spotted 35 sack cement plug from 1480 feet to 1440 feet;
15 sack cement plug from 0 feet to 10 feet.

RECEIVED
STATE CORPORATION COMMISSION

NOV 9 1965

CONSERVATION DIVISION
Wichita, Kansas

(If additional description is necessary, use BACK of this sheet)

Name of Plugging Contractor Garvey Drilling Company

Address Great Bend, Kansas

STATE OF Texas COUNTY OF Tarrant, ss.

B. J. Kellenberger (owner or operator) of the above-described

well, being first duly sworn on oath, says: That I have knowledge of the facts, statements, and matters herein contained and the log of the above-described well as filed and that the same are true and correct. So help me God.

(Signature) B. J. Kellenberger

Fort Worth, Texas

(Address)

SUBSCRIBED AND SWORN to before me this 8th day of November, 1965

My commission expires June 1, 1967

Mary C. Semmler
Notary Public.

