

15-129-10032-0000

STATE OF KANSAS  
STATE CORPORATION COMMISSION


Form CP-4

Give All Information Completely  
Make Required Affidavit  
Mail or Deliver Report to:  
Conservation Division  
State Corporation Commission  
211 No. Broadway  
Wichita, Kansas

WELL PLUGGING RECORD

Morton County. Sec. 3 Twp. 32 Rge. (E) 43(W)  
Location as "NE/CNW/SW" or footage from lines C SW  
Lease Owner Colorado Oil & Gas Corporation  
Lease Name Dreyer Well No. 1-3  
Office Address P.O. Box 158, Liberal, Kansas 67901  
Character of Well (completed as Oil, Gas or Dry Hole) Gas  
Date well completed January 27 1955  
Application for plugging filed April 15 1966  
Application for plugging approved April 18 1966  
Plugging commenced April 19 1966  
Plugging completed April 20 1966  
Reason for abandonment of well or producing formation Non Commercial

NORTH

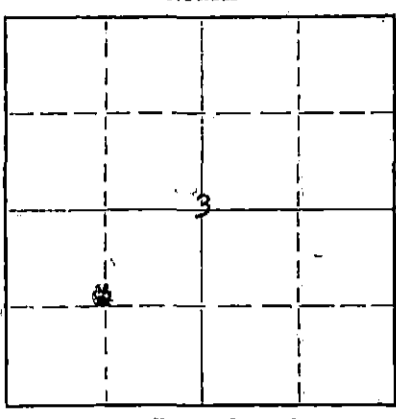

Locate well correctly on above  
Section Plat

If a producing well is abandoned, date of last production May 1964  
Was permission obtained from the Conservation Division or its agents before plugging was commenced? Yes

Name of Conservation Agent who supervised plugging of this well Edgar Eves  
Producing formation Topeka Depth to top 3144 Bottom 3153 Total Depth of Well 3158 Feet  
Show depth and thickness of all water, oil and gas formations.

OIL, GAS OR WATER RECORDS

CASING RECORD

FORMATION	CONTENT	FROM	TO	SIZE	PUT IN	PULLED OUT
<u>Topeka</u>	<u>Gas</u>	<u>3144</u>	<u>53</u>	<u>8-5/8</u> <u>5-1/2</u>	<u>616</u> <u>3358</u>	<u>None</u> <u>1910</u>

Describe in detail the manner in which the well was plugged, indicating where the mud fluid was placed and the method or methods used in introducing it into the hole. If cement or other plugs were used, state the character of same and depth placed, from \_\_\_\_\_ feet to \_\_\_\_\_ feet for each plug set.

Ran 20 sacks cement on bottom, 3144' to 3000'. Shot casing off at 1900'. Ran 35 sack cement plug at 650' to 550'. Ran 15 sacks cement plug at 45' to 3' below ground level.

RECEIVED  
STATE CORPORATION COMMISSION  
MAY 2 1966  
CONSERVATION DIVISION  
Wichita, Kansas

(If additional description is necessary, use BACK of this sheet)  
Name of Plugging Contractor Sargent's Casing Pulling Service  
Address P.O. Box 506, Liberal, Kansas 67901

STATE OF Kansas, COUNTY OF Seward, ss.  
L.H. Walters (employee of owner) or (owner or operator) of the above-described well, being first duly sworn on oath, says: That I have knowledge of the facts, statements, and matters herein contained and the log of the above-described well as filed and that the same are true and correct. So help me God.

(Signature) L.H. Walters  
P.O. Box 158, Liberal, Kansas 67901  
(Address)

SUBSCRIBED AND SWORN TO before me this 27th day of April, 1966.

My commission expires 11/1/66

William B. Claunch  
Notary Public.

Colorado Oil & Gas Corporation  
 Dreyer 1-3  
 C SW/4 Section 3-32-42  
 Morton County, Kansas

RECEIVED  
 STATE CORPORATION COMMISSION

NOV 12 1964

CONSERVATION DIVISION  
 Wichita, Kansas

Spudded: 10-11-54 Kuhn Drilling Company  
 Complete: 1-27-55  
 Elevation: 3596 GL

CASING RECORD

8-5/8" set at 619 GL w/300  
 5-1/2" set at 3358' GL w/100  
 TD 3405; PBTD 3158 GL

DRILLERS LOG

Surface Sand & Clay	0 to 345
Shaley Sand & Clay	519
Clay, Red Bed & Shale	640
Red Bed & Gypsum	980
Gypsum	1140
Red Bed & Shale, Anhydrite streaks	1480
Anhydrite	1520
Anhydrite & Red Bed	1670
Anhydrite & Shale	2135
Shale & Anhydrite	2490
Shale & Lime	2670
Lime	2880
Lime and Shale	3160
Lime	3310
Lime and Shale	3405 TD

April 15, 1966

Dreyer 1-3  
 C SW/4 Sec. 3-32-43  
 Morton County, Kansas

RECEIVED  
 STATE CORPORATION COMMISSION

APR 18 1966

CONSERVATION DIVISION  
 Wichita, Kansas

Elev. 3596' GL  
 October 11, 1954

8-5/8" 24# J-55 Smls 616 w/300 sax common  
 4% gel, 1/4# flocele/sx.

5-1/2" 14# J-55 Smls Set @3358' GL w/100 sx stratacrete  
 # 200 sax pozmix

Top Cement 1950'

TD 3405' GL PBD 3158'

Perf. 3144-53'

Tbg. 1-1/4" @3147'