


STATE OF KANSAS
STATE CORPORATION COMMISSION

WELL PLUGGING RECORD

Give All Information Completely
Make Required Affidavit
Mail or Deliver Report to:
Conservation Division
State Corporation Commission
212 No. Market
Wichita, Kansas

Kingman County. Sec. 15 Twp. 30S Rge. 7W (E) (W)
Location as "NE/CNW&SW" or footage from lines. SE SW NE
Lease Owner Tenneco Oil Company
Lease Name Kinert-Gilchrist LKC Unit Well No. 7
Office Address Suite 139, Ciudad Bldg., 3000 United Founders Blvd.
Okla. City, OK, 73112
Character of Well (completed as Oil, Gas or Dry Hole) Oil
Date well completed 10-15 19 61
Application for plugging filed 11-4 19 83
Application for plugging approved N.A. 19
Plugging commenced 12-6 19 83
Plugging completed 12-8 19 83
Reason for abandonment of well or producing formation Low oil production.

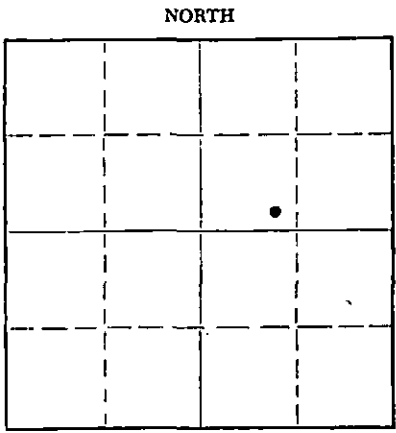

If a producing well is abandoned, date of last production. N.A. 19
Was permission obtained from the Conservation Division or its agents before plugging was commenced? Yes

Name of Conservation Agent who supervised plugging of this well _____
Producing formation Lansing Kansas City Depth to top 3722 Bottom 3727 Total Depth of Well 4178 Feet
Show depth and thickness of all water, oil and gas formations.

OIL, GAS OR WATER RECORDS				CASING RECORD		
FORMATION	CONTENT	FROM	TO	SIZE	PUT IN	PULLED OUT
<u>Lansing Kansas City</u>	<u>Oil</u>	<u>3722</u>	<u>3727</u>	<u>8-5/8"</u>	<u>256</u>	<u>None</u>
				<u>5-1/2"</u>	<u>3829</u>	<u>1225</u>

Describe in detail the manner in which the well was plugged, indicating where the mud fluid was placed and the method or methods used in introducing it into the hole. If cement or other plugs were used, state the character of same and depth placed, from _____ feet to _____ feet for each plug set.

- 12-83 Move in Pratt Well Service MD Rig Up, Pull Rods & Tubing.
- 12-83 Finish pulling tubing. Ran in Halliburton Retainer and 121 Jts 2-7/8" tubing. Cement bottom perf. with 100 sax Halliburton 60/40 poz with 3% C.C. Pull tubing in singles and lay down. Load hole with 9# mud and get ready to pull casing.
- 12-83 Pull stretch on 5-1/2", get approximately 20". Run in to shoot casing. Couldn't get below 1225. Shoot casing at 1225. Pull 36 jts. 5-1/2 & cut off. Cement top with 100 sx Halliburton 60/40 pos with 3% C.C. Rig down. Job is complete.

RECEIVED
STATE CORPORATION COMMISSION

FEB 23 1984

CONSERVATION DIVISION
Wichita, Kansas

(If additional description is necessary, use BACK of this sheet)
Name of Plugging Contractor Pratt Well Service
Address P. O. Box 847, Pratt, Kansas, 67124

2-23-84

STATE OF Oklahoma, COUNTY OF Oklahoma, ss.
Employee of Owner (employee of owner) or (owner or operator) of the above-described well, being first duly sworn on oath, says: That I have knowledge of the facts, statements, and matters herein contained and the log of the above-described well as filed and that the same are true and correct. So help me God.

(Signature) Kirk S. Harbert Kirk S. Harbert
Production Analyst
Suite 139, Ciudad Bldg., 3000 United Founders Blvd., Okla. City, OK, 73112
(Address)

Subscribed and sworn to before me this 20th day of February, 19 84
Karen A. Krumler
Notary Public.
My commission expires May 9, 1985

