


STATE OF KANSAS
STATE CORPORATION COMMISSION

WELL PLUGGING RECORD

Give All Information Completely
Make Required Affidavit
Mail or Deliver Report to:
Conservation Division
State Corporation Commission
212 No. Market
Wichita, Kansas

Kingman County, Sec. 15 Twp. 30S Rge. 7W (E) (W)

Location as "NE/CNW/SW" or footage from lines NE SE NW
Lease Owner Tenneco Oil Company
Lease Name Kinert-Gilchrist LKC Unit Well No. 85
Office Address Suite 139, Ciudad Bldg., 3000 United Founders Blvd.
Okla. City, OK, 73112
Character of Well (completed as Oil, Gas or Dry Hole) Oil
Date well completed 1-21 19 59
Application for plugging filed 11-4 19 83
Application for plugging approved N.A. 19
Plugging commenced 11-23 19 83
Plugging completed 12-1 19 83
Reason for abandonment of well or producing formation Low Oil Production

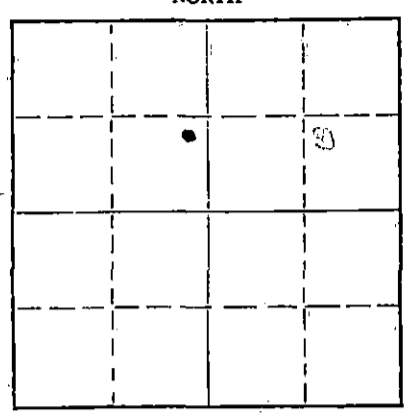

Locate well correctly on above Section Plat

If a producing well is abandoned, date of last production N.A. 19
Was permission obtained from the Conservation Division or its agents before plugging was commenced? Yes

Name of Conservation Agent who supervised plugging of this well
Producing formation Lansing Kansas City Depth to top 3734 Bottom 3736 Total Depth of Well 4190 Feet
Show depth and thickness of all water, oil and gas formations.

OIL, GAS OR WATER RECORDS

CASING RECORD

| FORMATION | CONTENT | FROM | TO | SIZE | PUT IN | PULLED OUT |
|---------------------|---------|------|------|--------|--------|------------|
| Lansing Kansas City | Oil | 3734 | 3736 | 8-5/8" | 252 | None |
| | | | | 5-1/2" | 4190 | 2675 |
| | | | | | | |
| | | | | | | |
| | | | | | | |
| | | | | | | |

Describe in detail the manner in which the well was plugged, indicating where the mud fluid was placed and the method or methods used in introducing it into the hole. If cement or other plugs were used, state the character of same and depth placed, from _____ feet to _____ feet for each plug set.


- 11-23-83 MIRU PU. LD 148-3/4" rods in singles, 1-6' pony rod. Pulled 123 joints 2-7/8" 8rd tbg. Shut down.
- 11-29-83 Air lines froze up on pulling unit - had thawed by 11:15 AM. Ran in hole w/EZSU Halliburton cmt retainer set @ 3620' - 119 jts 2-7/8". Pumped water thru tbg to get inj. rate - took 11-1/2 BBLS to load tbg. est FL @ 2000'. Had a rate of 5 bpm @ 900-100#. Pumped 100 sx 60/40 pos, 3% gel-98 below retainer, 2 above. Pulled 119 jts 2-7/8" 8rd tbg. - LD in singles. Moved Halliburton to KGKCLU #5 & filled to surface w/cmt approx. 100'. RU 5-1/2" elevators, slips, etc. Loaded hole on KGKCLU #6 w/9# gel. Shut down.
- 11-30-83 MIRU Wiretech. Pull 14-1/2" stretch, work pipe, run in w/wireline & find top of btm. cmt plug @ 3470'. Shoot off 5-1/2" csg @ 2675'. Recover 72 jts. 5-1/2" 14# csg, Cmt top plug w/100 sx 60/40 pos 3% gel, 6 sx gel, 6 sx gel, 50 sx, plug, 50 sx.
- 12-1-83 RD

(If additional description is necessary, use BACK of this sheet)

Name of Plugging Contractor Pratt Well Service
Address P. O. Box 847, Pratt, Kansas, 67124

STATE OF Oklahoma, COUNTY OF Oklahoma, ss.
Employee of Owner _____ (employee of owner) or (owner or operator) of the above-described well, being first duly sworn on oath, says: That I have knowledge of the facts, statements, and matters herein contained and the log of the above-described well is filled and that the same are true and correct. So help me God.

(Signature) Kirk S. Harbert, Prod. Anyl.
Suite 139, Ciudad Bldg., 3000 United Founders Blvd., Okla. City, OK, 73112 (Address)

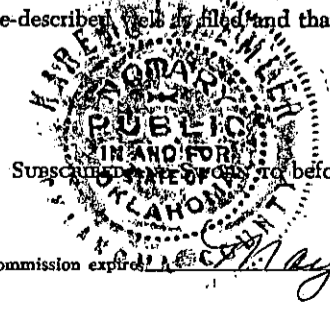

Subscribed and sworn to before me this 30th day of February, 1984
My commission expires May 7, 1985

RECEIVED
STATE CORPORATION COMMISSION Notary Public.

FEB 23 1984 2-23-84

STATE OF KANSAS
STATE CORPORATION COMMISSION
200 Colorado Derby Bldg.
Wichita, Kansas 67202

Form CP-4
Rev. 12-15-80

WELL PLUGGING RECORD

Give All Information Completely
Make Required Affidavit

COUNTY Kingman SEC. 15 TWP. 30S RGE. 7 XE/W
Location as in quarters or footage from lines:

| | | | |
|--|--|--|--|
| | | | |
| | | | |
| | | | |
| | | | |

Lease Owner Tenneco
Lease Name KGLKCU Well No. 8-5
Office Address Box 1485 Great Bend, Ks. 67530
Character of Well (Completed as Oil, Gas or Dry Hole): Oil
Date Well Completed Jan. 7, 1959
Application for plugging filed October, 1983
Plugging commenced Nov. 23, 1983
Plugging completed Dec. 1, 1983
Reason for abandonment of well or producing formation

Locate Well
correctly on above
Section Platt.

Not economical to produce
Was permission obtained from the Conservation Division or it's
Agent's before plugging was commenced? yes

Name of Conservation Agent who supervised plugging of this well Morris Lesley
Producing formation KC Mississippi Depth to top _____ bottom T.D. 4190'
Show depth and thickness of all water, oil and gas formations. PB TD 4160'

OIL, GAS OR WATER RECORDS

Casing Record

| Formation | Content | From | To | Size | Put in | Pulled Out |
|-----------|---------|------|----|-------|--------|------------|
| | | 0 | | 8 5/8 | | 0 |
| | | | | 5 1/2 | | 73 its. |
| | | | | | | |
| | | | | | | |

Describe in detail the manner in which the well was plugged, indicating where the mud fluid was placed and the method or methods used in introducing it into the hold. If cement or other plugs were used, state the character of same and depth placed, from _____ feet to _____ feet for each plug set. Perfs at 3732-37' and 4126-32'. Shot off pipe at 2675'
Pumped 50 sx. cement above and below EZSU Hallco cement retainer at 3620'. Top hole plugging: 10 sx. cement 60/40 poz mix, 3% CC, 3% gel.

(If additional description is necessary, use BACK of this sheet)

Name of Plugging Contractor Pratt Well Service, Inc.

STATE OF Kansas COUNTY OF Pratt, ss.
Judy Berry (employee of owner) or (owner or operator) of the
above-described well, being first duly sworn on oath, says: That I have knowledge of the
facts, statements, and matters herein contained and the log of the above-described well as
filed and that the same are true and correct. So help me God.



(Signature) Judy Berry
Box 847 Pratt, Ks.
(Address)

SUBSCRIBED AND SWORN TO before me this 19th day of March, 19 84
Charlene M. Dudgey
Notary Public

My Commission expires: 9/10/86
STATE CORPORATION COMMISSION
CONSERVATION DIVISION
Wichita, Kansas
MAR 21 1984
3-21-84