


15-095-20321-0000

STATE OF KANSAS
CORPORATION COMMISSION
All Information Completely
Make Required Affidavit
Mail or Deliver Report to:
Conservation Division
State Corporation Commission
P. O. Box 17027
Wichita, Kansas 67217
NORTH

Form CP-4

WELL PLUGGING RECORD

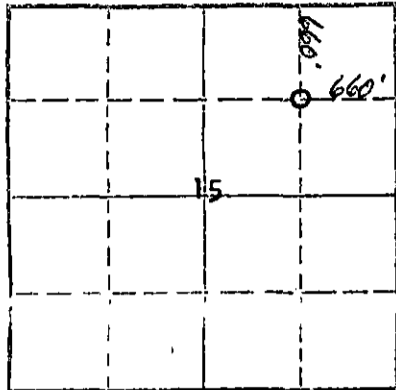

Locate well correctly on above Section Plat

Kingman County, Sec. 15 Twp. 30 Rge. (E) 7 (W)
Location as "NE/CNW/SE/SW" or footage from lines C-NE-NE (660' FNL & 660' FEL)
Lease Owner Union Oil Company of California
Lease Name J. X. Kinert Well No. 2-15
Office Address 2000 Classen Center So. Bldg. Okla. City, Okla. 73106
Character of Well (completed as Oil, Gas or Dry Hole) Dry Hole
Date well completed 9-12-73 19
Application for plugging filed 9-12-73 19
Application for plugging approved (Confirming) 19
Plugging commenced 9-12-73 19
Plugging completed 9-13-73 19
Reason for abandonment of well or producing formation Dry no show

If a producing well is abandoned, date of last production - 19
Was permission obtained from the Conservation Division or its agents before plugging was commenced? Yes

Name of Conservation Agent who supervised plugging of this well
Producing formation Simpson Depth to top 4486 Bottom 4560 Total Depth of Well 4560 Feet
Show depth and thickness of all water, oil and gas formations.

OIL, GAS OR WATER RECORDS

CASING RECORD

FORMATION	CONTENT	FROM	TO	SIZE	PUT IN	PULLED OUT
Simpson	Dry	4486	4560	8-5/8"	268'	None

Describe in detail the manner in which the well was plugged, indicating where the mud fluid was placed and the method or methods used in introducing it into the hole. If cement or other plugs were used, state the character of same and depth placed, from feet to feet for each plug set.

Ran in hole with drill pipe and spotted heavy drilling mud from 4560 to 500', spotted 50 sx. reg. cement plug from 500' to 350', heavy drilling mud from 350' to 250', spotted 25 sx. reg. cmt. plug from 250' to 188', heavy drilling mud from 188' to 40', spotted 10 sx. reg. cmt. plug from 40' to 7', cut 8-5/8" csg. off 7' below ground level and welded on steel cap and cleaned up location. Well P&A @ 7AM 9-13-73.

RECEIVED
STATE CORPORATION COMMISSION

SEP 17 1973

CONSERVATION DIVISION
Wichita, Kansas

9-17-73

(If additional description is necessary, use BACK of this sheet)
Name of Plugging Contractor Graves Drilling Company Inc.
Address 505 Union Center - Wichita, Kansas 67202

STATE OF Oklahoma, COUNTY OF Oklahoma, SS.
J. D. Norman (employee of owner) of the above-described well, being first duly sworn on oath, says: That I have knowledge of the facts, statements, and matters herein contained and the log of the above-described well as filed and that the same are true and correct. So help me God.

(Signature) J. D. Norman
2000 Classen Center South Building
Oklahoma City, Oklahoma 73106

SUBSCRIBED AND SWORN TO before me this 14th day of September, 1973

Mada Cooper Notary Public

ROTARY DRILLERS' LOG

OPERATOR: Union Oil Company of California
 2000 Classen Center, South Building
 Oklahoma City, Oklahoma 73106

DRILLING COMMENCED: September 4, 1973

CONTRACTOR: Graves Drilling Co., Inc.
 505 Union Center
 Wichita, Kansas 67202

DRILLING COMPLETED: September 13, 1973

CASING RECORD: 13 Jts. 268' 8-5/8"
 cemented with 250 sacks

LOCATION: J. X. Kinert No. 2-15
 NE NE
 Section 15-30S-7W
 Kingman County, Kansas

RECEIVED
 STATE CORPORATION COMMISSION
 SEP 19 1973
 CONSERVATION DIVISION
 Wichita, Kansas

9-19-73

0 - 35	Sand
35 - 268	Red bed
268 - 820	Shale
820 - 1087	Shale & shells
1087 - 1915	Shale & lime
1915 - 2905	Lime & shale
2905 - 3110	Shale & lime
3110 - 3255	Lime & shale
3255 - 3274	Shale
3274 - 3445	Lime
3445 - 3655	Lime with shale
3655 - 4090	Lime & shale
4090 - 4095	Cherty lime
4095 - 4275	Cherty lime & shale
4275 - 4360	Lime
4360 - 4455	Lime & shale
4455 - 4584	Lime
4584 - 4560	Sand
4560	Rotary Total Depth

I hereby certify the foregoing statements to be true and correct to the best of my knowledge.

GRAVES DRILLING CO., INC.

By John Graves President

STATE OF KANSAS)
) ss.
 SEDGWICK COUNTY)

Subscribed and sworn to before me, a Notary Public, this 17th of September, 1973.

My commission expires:
 May 9, 1975

Betty Brandt
 Betty Brandt Notary Public