

15-187-00040-0000


STATE OF KANSAS
STATE CORPORATION COMMISSION

WELL PLUGGING RECORD

Give All Information Completely
Make Required Affidavit
Mail or Deliver Report to:
Conservation Division
State Corporation Commission
211 No. Broadway
Wichita, Kansas

STANTON County, Sec. 12 Twp. 29S Rge. 42 (EX) (W)

Location as "NE/CNW/SW" or footage from lines C SW/4
Lease Owner Graham-Michaelis Drilling Co.
Lease Name WILLIAMS Well No. 1
Office Address 211 North Broadway, Wichita, Ks.
Character of Well (completed as Oil, Gas or Dry Hole) Dry Hole
Date well completed 7-24-57 19
Application for plugging filed 7-24-57 19
Application for plugging approved 7-25-57 19
Plugging commenced 7-24-57 19
Plugging completed 7-24-57 19
Reason for abandonment of well or producing formation Dry Hole

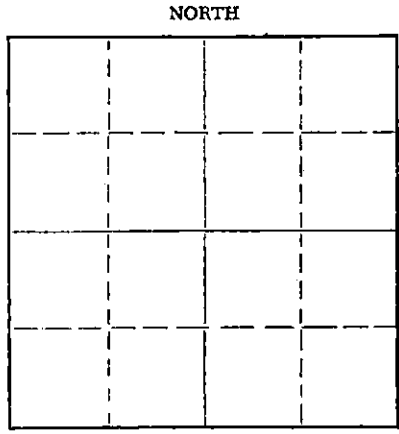

Locate well correctly on above Section Plat

If a producing well is abandoned, date of last production _____ 19____
Was permission obtained from the Conservation Division or its agents before plugging was commenced? Yes

Name of Conservation Agent who supervised plugging of this well M. A. RIVES, BOX 8, PRATT, KANSAS
Producing formation _____ Depth to top _____ Bottom _____ Total Depth of Well 5550 Feet
Show depth and thickness of all water, oil and gas formations.

OIL, GAS OR WATER RECORDS

CASING RECORD

FORMATION	CONTENT	FROM	TO	SIZE	PUT IN	PULLED OUT
<u>Sand, Clay, Shale,</u>						
<u>Red Bed, Shells &</u>						
<u>Anhydrite</u>		<u>0</u>	<u>1575*</u>	<u>8 5/8"</u>	<u>1575*</u>	<u>0</u>

Describe in detail the manner in which the well was plugged, indicating where the mud fluid was placed and the method or methods used in introducing it into the hole. If cement or other plugs were used, state the character of same and depth placed, from _____ feet to _____ feet for each plug set.

Finished laying down drill pipe and plugged hole with 25 sacks cement.
Plug 8 1/3 sacks hulls @600*, mud to 35*. Plug 1/3 sacks hulls - 10 sacks
cement. Plugged @10:30 P.M.

(If additional description is necessary, use BACK of this sheet)

Name of Plugging Contractor Graham-Michaelis Drilling Company
Address 211 North Broadway, Wichita, Kansas

STATE OF KANSAS, COUNTY OF SEDGWICK, ss.
JOHN L. JAMES (employee of owner) or ~~owner~~ of the above-described well, being first duly sworn on oath, says: That I have knowledge of the facts, statements, and matters herein contained and the log of the above-described well as filed and that the same are true and correct. So help me God. Graham-Michaelis Drilling Co.

(Signature) John L. James
211 North Broadway, Wichita, Kansas
(Address)

SUBSCRIBED AND SWORN TO before me this 30th day of July, 19 57

T. J. Grier

My commission expires 1/7/61

Notary Public.
RECEIVED
STATE CORPORATION COMMISSION
8-6-57
AUG 6 1957
CONSERVATION DIVISION
Wichita, Kansas

PLUGGING
FILE SEC. 12 T. 29 R. 42W
BOOK PAGE 21 LINE 10

WILLIAMS #1

Well Record

Location: C SW/4 Section 12-29S-42W Stanton County, Kansas
 Commenced: July 4, 1957
 Completed: July 25, 1957 (rotary)

Operator: Graham-Michaelis Drilling Co.
 211 North Broadway
 Wichita, Kansas

Contractor: Graham-Michaelis Drilling Co.
 211 North Broadway
 Wichita, Kansas

Casing Record: 8 5/8" @1575' W/300msacks cement

LOG

Sand & Clay	60
Sand, Shale & Clay	930
Red Bed & Shells	1173
Shale & Anhydrite	1300
Anhydrite, Sand & Shale	1510
Shale & Anhydrite	2109
Shale & Lime	2259
Lime & Shale	3220
Lime	3595
Lime & Shale	3810
Lime	4359
Lime & Shale	4405
Lime	4506
Lime & Shale	4654
Lime	4886
Lime & Shale	4933
Lime	4987
Lime & Shale	5010
Lime	5064
Lime & Shale	5097
Shale	5376
Lime	5550, RTD.

STATE OF KANSAS)
) ss.
 COUNTY OF SEDGWICK)

The undersigned, GRAHAM-MICHAELIS DRILLING COMPANY, hereby certifies that the above log is a true and correct log of the formations encountered in drilling the above well as reflected by the Daily Drilling Report.

GRAHAM-MICHAELIS DRILLING CO.

By John L. James
 John L. James, Geologist.

Subscribed and sworn to before me this 30th day of July, 1957.

J. D. [Signature]
 My commission expires: 1/7/61.

PLUGGING
 FILE SEC. 12 T. 29 R. 42W
 BOOK PAGE 31 LINE 10

RECEIVED
 STATE CORPORATION COMMISSION
 8-6-57
 AUG 6 1957
 CORPORATION DIVISION