


STATE OF KANSAS
STATE CORPORATION COMMISSION

WELL PLUGGING RECORD

Give All Information Completely
Make Required Affidavit
Mail or Deliver Report to
Conservation Division
State Corporation Comm.
245 North Water
Wichita, KS 67202

Stanton County, Sec. 10 Twp. 29 Rge. 42 E/W
Location as "NE/CNW $\frac{1}{4}$ SW $\frac{1}{4}$ " or footage from lines
C NE SW

Lease Owner Petroleum Inc.
Lease Name Hoopingarner Well No. #1
Office Address P.O. Box 1255 Liberal, KS 67901
Character of Well (Completed as Oil, Gas or Dry Hole) Dry Hole

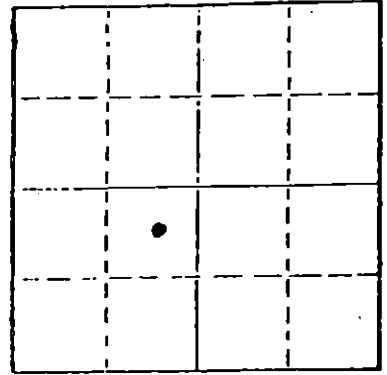

Locate well correctly on above
Section Plot

Date Well completed 6/15/80 19
Application for plugging filed 6/26/80 19
Application for plugging approved 19
Plugging commenced 6/17/80 19
Plugging completed 6/17/80 19
Reason for abandonment of well or producing formation Dry
If a producing well is abandoned, date of last production 19

Was permission obtained from the Conservation Division or its agents before plugging was commenced? Yes

Name of Conservation Agent who supervised plugging of this well Clarence Thomas
Producing formation Depth to top Bottom Total Depth of Well 5775'
Show depth and thickness of all water, oil and gas formations.

OIL, GAS OR WATER RECORDS

CASING RECORD

| FORMATION | CONTENT | FROM | TO | SIZE | PUT IN | PULLED OUT |
|-----------|---------|------|----|------|--------|------------|
| | | | | | | |
| | | | | | | |
| | | | | | | |
| | | | | | | |

Describe in detail the manner in which the well was plugged, indicating where the mud fluid was placed and the method or methods used in introducing it into the hold. If cement or other plugs were used, state the character of same and depth placed, from feet to feet for each plug set.

- 35 sks. cement @ 2350' - 2250'
- 50 sks. cement @ 1550' - 1450'
- 10 sks. cement @ 40-3'
- 5 sks. cement mouse hole
- 5 sks. cement rat hole

(If additional description is necessary, use BACK of this sheet)

Name of Plugging Contractor Zenith Drilling Corporation

STATE OF Kansas COUNTY OF Seward, ss.
Merle Evers (employee of owner) or ~~(owner/owner's representative)~~

of the above-described well, being first duly sworn on oath, says: That I have knowledge of the facts, statements, and matters herein contained and the log of the above-described well as filed and that the same are true and correct. So help me God.

(Signature) Merle Evers
P.O. Box 1255 Liberal, KS 67901
(Address)

SUBSCRIBED AND SWORN TO before me this 26th day of June, 1980

STATE NOTARY PUBLIC
KANSAS
JAMES R. HATFIELD
Seward County, Kansas
My Appt. Exp. 2-25-82

James R. Hatfield
Notary Public.

My commission expires

RECEIVED
STATE CORPORATION COMMISSION

JUN 30 1980

6-30-80

WELL LOG

COMPANY Petroleum, Inc.

SEC. 10-29-42W

FARM Hoopingarner

NO. 1

LOC. NE SW


TOTAL DEPTH 5775'

COUNTY Stanton, Kansas

COMM. 6-02-80

COMP. 6-15-80

CONTRACTOR Zenith Drilling Corporation

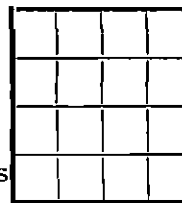

CASING

Ran 38 jts., new, 24#, 8 5/8" csg., cemented with 800 sacks cement.

ELEVATION

PRODUCTION

FIGURES INDICATE BOTTOM OF FORMATIONS

| | |
|-----------------------|------|
| Sand | 41 |
| Shells & Sand | 304 |
| Sand & Shale | 560 |
| Clay & Red Bed | 820 |
| Sand | 1525 |
| Sand & Shale | 2100 |
| Shale, Red Bed & Lime | 2450 |
| Lime & Shale | 3720 |
| Lime | 3930 |
| Lime & Shale | 4240 |
| Lime | 4450 |
| Lime & Shale | 4770 |
| Lime | 4900 |
| Lime & Shale | 5775 |

PLUGGING INFORMATION

35 sacks cement at 2350'
 50 sacks cement at 1550'
 10 sacks cement at 40-3'

5 sacks cement in mouse hole and 5 sacks in rat hole.

Job complete at 8:00 P.M. 6-17-80.

State of Kansas }
 County of Sedgwick } ss

I, Emmet E. Hall of Zenith Drilling Corporation
 upon oath state the above and foregoing is a true and correct copy of the log of the Hoopingarner #1 well.

Emmet E. Hall

Subscribed and sworn to before me this 20th day of June, 19 80.

My Commission Expires: 12/15/80

Sharon R. Allen
 Sharon R. Allen
 STATE COMMISSIONER
 NOTARY PUBLIC

JUN 27 1980
 6-27-80
 CONSERVATION DIVISION
 Wichita, Kansas