


15-187-00030-0000

STATE OF KANSAS
STATE CORPORATION COMMISSION

WELL PLUGGING RECORD

Give All Information Completely
Make Required Affidavit
Mail or Deliver Report to:
Conservation Division
State Corporation Commission
800 Biting Building
Wichita, Kansas

43W
NORTH

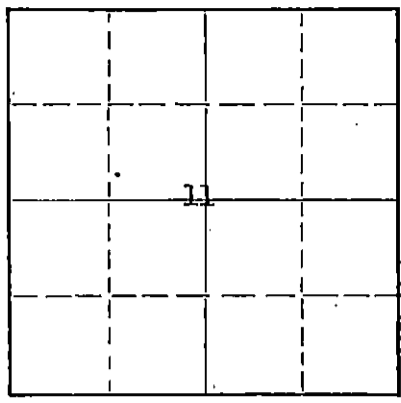

Locate well correctly on above Section Plat

Stanton County, Kansas County. Sec. 11 Twp. 29S Rge. 43W (E) (W)
Location as "NE/CNW/SW" or footage from lines SE SE SE
Lease Owner Van-Grisso Oil Company et al.
Lease Name Cockrum Well No. 1
Office Address 1012 City Nat'l Bldg., Okla City 2, Oklahoma
Character of Well (completed as Oil, Gas or Dry Hole) dry hole
Date well completed July 17, 1955 19
Application for plugging filed July 17, 1955 (field application) 19
Application for plugging approved July 17, 1955 (" approval) 19
29S Plugging commenced July 17, 1955 19
Plugging completed July 17, 1955 19
Reason for abandonment of well or producing formation dry hole

If a producing well is abandoned, date of last production no production - dry hole
Was permission obtained from the Conservation Division or its agents before plugging was commenced? yes

Name of Conservation Agent who supervised plugging of this well M. A. Rives
Producing formation none Depth to top X Bottom X Total Depth of Well 5650' Feet
Show depth and thickness of all water, oil and gas formations.

OIL, GAS OR WATER RECORDS

CASING RECORD

FORMATION	CONTENT	FROM	TO	SIZE	PUT IN	PULLED OUT
none				8-5/8"	1474'	none
				Set with 700 sx. Posmix cement with 2% calcium chloride		

Describe in detail the manner in which the well was plugged, indicating where the mud fluid was placed and the method or methods used in introducing it into the hole. If cement or other plugs were used, state the character of same and depth placed, from feet to feet for each plug set.

Hole pumped full of drilling mud; then pushed wooden plug to 550' with drill pipe; then Halliburton truck set first plug at 550' with 35 sx. Posmix cement and then set second plug at 35' and cemented to base of collar with 15 sx. cement.

RECEIVED
STATE CORPORATION COMMISSION
AUG 25 1955
CONSERVATION DIVISION
Wichita, Kansas

8-25-55

(If additional description is necessary, use BACK of this sheet)
Name of Plugging Contractor Plugged by Moran Bros., Inc., Drilling contractor of Wichita Falls,
Address Texas and Halliburton Oil Well Cementing Company, Duncan, Oklahoma

STATE OF Oklahoma, COUNTY OF Oklahoma, ss.
W. D. Grisso - President of Van-Grisso Oil Company (employee of owner) or (owner or operator) of the above-described well, being first duly sworn on oath, says: That I have knowledge of the facts, statements, and matters herein contained and the log of the above-described well as filed and that the same are true and correct. So help me God.

(Signature) [Signature]
W. D. Grisso
1012 City National Bldg., Okla City, Okla
(Address)

SUBSCRIBED AND SWORN to before me this 20th day of July, 19 55

My commission expires January 7, 1957
Mary Pylant Notary Public.

PLUGGING
WEL SEC 11 T 29 R 43W
BOOK PAGE 135 LINE 22

LEASE OWNER: VAN-GRISSE OIL COMPANY ET AL
 1012 City National Building
 Oklahoma City 2, Oklahoma

DESCRIPTION: COCKRUM #1
 & WELL NAME: SE SE SE Sec. 11-29S-43W
 Stanton County, Kansas

DRILLERS' LOG

FORMATION	FROM	TO
Sand	0'	185'
Shale & Gyp	185'	805
Shale & red bed	805	1115
Shale, gyp & anhydrite	1115	1485
Shale & shell	1485	1490
Red shale & shells	1490	1890
Shale & shells	1890	2532
Shale & lime	2532	2840
Shale & shells	2840	2980
Shale & lime	2980	3177
Lime	3177	3240
Lime, streaks anhydrite, sand & shale	3240	3312
Lime	3312	3428
Sandy lime	3428	3463
Lime	3463	3506
Chalk & lime	3506	3518
Lime	3518	3680
Lime & shale	3680	3737
Lime	3737	4170
Broken lime	4170	4348
Lime	4348	4493
Lime & shale with pyrite	4493	4528
Lime	4528	4842
Shale & sand	4842	4865
Broken lime	4865	4941
Shale & lime streaks	4941	4987
Lime & shale	4987	5072
Shale & lime streaks	5072	5089
Black shale	5089	5195
Shale & lime streaks	5195	5277
Black shale	5277	5307
Lime & sand	5307	5395
Lime	5395	5422
Sand	5422	5426
Lime	5426	5650
TD		5650'

Dated this 20th day of July, 1955

Filed by Van-Grisso Oil Company
 1012 City National Building
 Oklahoma City 2, Oklahoma

Well commenced June 20, 1955
 Well completed July 17, 1955 as a dry hole

RECEIVED
 STATE CORPORATION COMMISSION
 AUG 25 1955
 CONSERVATION DIVISION
 Wichita, Kansas

8-25-55

mp

PLUGGING
 FILE SEC Y R
 BOOK PAGE LINE