

15-187-00013-0000

STATE OF KANSAS
STATE CORPORATION COMMISSION

WELL PLUGGING RECORD

Give All Information Completely
Make Required Affidavit
Mail or Deliver Report to:
Conservation Division
State Corporation Commission
211 No. Broadway
Wichita, Kansas

Stanton

County. Sec. 10 Twp. 29S Rge. 43W (E) (W)

Location as "NE/CNW/SW" or footage from lines C NW/4

Lease Owner The Superior Oil Company

Lease Name Bearce Well No. 1

Office Address Box 690, Chickasha, Oklahoma

Character of Well (completed as Oil, Gas or Dry Hole) Dry hole

Date well completed June 6, 19 60

Application for plugging filed June 6, 19 60

Application for plugging approved June 6, 19 60

Plugging commenced June 6, 19 60


Plugging completed June 7, 19 60

Reason for abandonment of well or producing formation Dry hole

If a producing well is abandoned, date of last production 19

Was permission obtained from the Conservation Division or its agents before plugging was commenced? Yes

NORTH

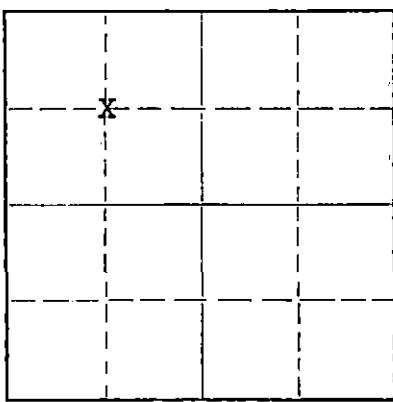

Locate well correctly on above Section Plat

Name of Conservation Agent who supervised plugging of this well Mr. Frank Broadfoot

Producing formation Depth to top Bottom Total Depth of Well 5540 Feet

Show depth and thickness of all water, oil and gas formations.

OIL, GAS OR WATER RECORDS

CASING RECORD

FORMATION	CONTENT	FROM	TO	SIZE	PUT IN	PULLED OUT
Morrow Sand	Salt water	5438	5472	8-5/8"	1614'	None

Describe in detail the manner in which the well was plugged, indicating where the mud fluid was placed and the method or methods used in introducing it into the hole. If cement or other plugs were used, state the character of same and depth placed, from feet to feet for each plug set.

Equalized 100 sack cement plug with pipe at 5520'.
Equalized 60 sack cement plug with pipe at 784' (top of plug at 600')

Note: The land owner, with the permission of Mr. Broadfoot, will complete this well as a fresh water irrigation well.

RECEIVED
STATE CORPORATION COMMISSION

JUN 9 1960

CONSERVATION DIVISION
Wichita, Kansas

6-9-60

(If additional description is necessary, use BACK of this sheet)

Name of Plugging Contractor Capitt Drilling Co.
Address 814 Union Center, Wichita, Kansas

STATE OF Oklahoma, COUNTY OF Grady, ss.

O. V. Sivage, Petroleum Engineer (employee of owner) or (owner or operator) of the above-described well, being first duly sworn on oath, says: That I have knowledge of the facts, statements, and matters herein contained and the log of the above-described well as filed and that the same are true and correct. So help me God.

(Signature) O. V. Sivage
Box 690, Chickasha, Oklahoma

SUBSCRIBED AND SWORN TO before me this 8th day of June, 19 60

My commission expires Sept. 15, 1960

M. J. Fregel
Notary Public

The Superior Oil Company

RECEIVED
STATE CORPORATION COMMISSION
6-9-60
JUN 9 1960

Bearce #1
C NW/4 Section 10-29S-43W
Stanton County, Kansas

CONSERVATION DIVISION
Wichita, Kansas

Well Log:	0' To	710 Shale & red beds	(bottom of formation)
		865 Shale	
		1,614 Shale & lime	
		1,970 Sand & red beds	
		2520 Shale & lime	
		2,613 Lime	
		2,726 Shale & lime	
		2,813 Lime	
		3,052 Sand & lime	
		3,318 Lime	(Top Elmont 3198 (/ 394)
		3,359 Lime	(Topeka)
		5,112 Shale & lime	
		5,112 Shale	(Morrow Shale)
		5,540 Sand & lime	
		5,540 Total Depth	

Elevation: 3590' DF, 3592' KB