

15-187-00062-0000

R

STATE OF KANSAS
STATE CORPORATION COMMISSION

Give All Information Completely
Make Required Affidavit
Mail or Deliver Report to:
Conservation Division
State Corporation Commission
211 No. Broadway
Wichita, Kansas

WELL PLUGGING RECORD

Stanton

County. Sec. 31 Twp. 29S Rge. C. NW/4 (E) 42(W)

Location as "NE/CNW/SW" or footage from lines _____

Lease Owner Sunray Mid-Continent Oil Company

Lease Name Santa Fe - Wheeler Well No. 1

Office Address 321 W. Douglas - Wichita 2, Kansas

Character of Well (completed as Oil, Gas or Dry Hole) Dry Hole

Date well completed December 23 19 60

Application for plugging filed December 23 19 60

Application for plugging approved December 27 19 60


Plugging commenced December 23 19 60

Plugging completed December 23 19 60

Reason for abandonment of well or producing formation Dry

If a producing well is abandoned, date of last production None 19 _____

Was permission obtained from the Conservation Division or its agents before plugging was commenced? Yes

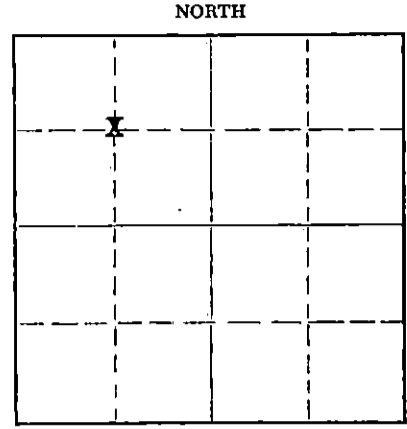

Locate well correctly on above Section Plat

Name of Conservation Agent who supervised plugging of this well Frank Broadfoot

Producing formation --- Depth to top --- Bottom --- Total Depth of Well 5600 Feet

Show depth and thickness of all water, oil and gas formations.

OIL, GAS OR WATER RECORDS

CASING RECORD

FORMATION	CONTENT	FROM	TO	SIZE	PUT IN	PULLED OUT
Mississippi	Dry	5476	5510	8-5/8	1610	None
Keyes (Morrow)	Dry	5429	5460			

Describe in detail the manner in which the well was plugged, indicating where the mud fluid was placed and the method or methods used in introducing it into the hole. If cement or other plugs were used, state the character of same and depth placed, from _____ feet to _____ feet for each plug set.

Filled hole with mud and placed wooden plug at 1550' with 5 sacks cement on top. Filled with mud to 700' and placed wooden plug with 25 sacks hulls and 10 sacks cement on top. Welded steel plate on top of surface casing.

REGISTRATION
STATE CORP COM
12-30-60

CONSERVATION DIVISION
Wichita, Kansas

(If additional description is necessary, use BACK of this sheet)

Name of Plugging Contractor _____

Address _____

STATE OF Kansas, COUNTY OF Sedgwick, ss. N. A. Gough (employee of owner) or (~~owner~~) of the above-described

well, being first duly sworn on oath, says: That I have knowledge of the facts, statements, and matters herein contained and the log of the above-described well as filed and that the same are true and correct. So help me God.

(Signature) N. A. Gough

321 West Douglas - Wichita 2, Kansas
(Address)

SUBSCRIBED AND SWORN TO before me this 29th day of December, 19 60

My commission expires July 13, 1963

W. M. Montgomery
Notary Public.



15-187-00062-0000


WELL LOG BUREAU—KANSAS GEOLOGICAL SOCIETY
508 East Murdock, Wichita, Kansas

Company- SUNRAY MID-CONTINENT OIL CO.
Farm- Santa Fe-Wheeler No. 1

SEC. 31 T. 29 R. 42W
C NW

Total Depth. 5600'
Comm. 12-3-60 Comp. 12-23-60
Shot or Treated.
Contractor: Stickle Drlg. Co.
Issued. 8-12-61

County Stanton
KANSAS

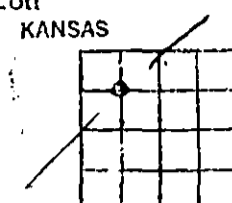

CASING:
8. 5/8" 1610' cem w/100 sx.

Elevation. 3576' RB

Production. Dry

Figures Indicate Bottom of Formations.

surface clay & sand	70
sand & lime	365
shale & lime streaks	693
shale & sand	930
sand & shale	1134
lime & shale	1179
shale & sand	1472
shale & anhydrite	1537
shale & lime	1880
shale & shells	2030
shale	2735
shale w/lime streaks	2916
lime & shale	3070
shale & lime	3318
lime & shale	3489
lime	3838
lime & shale	3944
lime & shale streaks	3998
lime & shale	4089
lime	4139
lime w/shale streaks	4239
lime & shale	4330
lime	4881
lime & shale	5070
shale & lime	5142
lime & shale	5213
shale w/lime streaks	5271
shale & lime	5385
lime & shale	5481
lime	5502
lime & shale	5550
lime	5600

Total Depth

TOPS: SCOUT	
Base Anhydrite	1548
Shawnee	3197
Lansing	3748
Marmaton	4286
Cherokee	4470
Atoka	4689
Morrow	5063
Keyes	5429
Mississippi	5476
St. Genevieve	5510