


STATE OF KANSAS  
STATE CORPORATION COMMISSION

WELL PLUGGING RECORD

Give All Information Completely  
Make Required Affidavit  
Mail or Deliver Report to  
Conservation Division  
State Corporation Comm.  
245 North Water  
Wichita, KS 67202

Stanton County, Sec. 18 Twp. 29S Rge. 42 E/W  
Location as "NE/CNW $\frac{1}{4}$ /SW $\frac{1}{4}$ " or footage from lines  
C NW SW

Lease Owner National Oil Company  
Lease Name Bilbery Well No. 1  
Office Address Suite 550, 200W. Douglas, Wichita, Ks  
Character of Well (Completed as Oil, Gas or Dry Hole) 67202  
dry hole

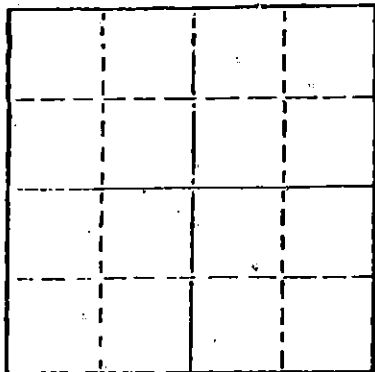

Locate well correctly on above  
Section Plat

Date Well completed 2-14 1979  
Application for plugging filed 2-14 1979  
Application for plugging approved 2-14 1979  
Plugging commenced 2-14 1979  
Plugging completed 2-14 1979

Reason for abandonment of well or producing formation  
no commercial quantities of oil or gas encountered  
If a producing well is abandoned, date of last production  
-- 19

Was permission obtained from the Conservation Division or  
its agents before plugging was commenced? yes

Name of Conservation Agent who supervised plugging of this well Clarence Thomas  
Producing formation Depth to top Bottom Total Depth of Well 5635  
Show depth and thickness of all water, oil and gas formations.

OIL, GAS OR WATER RECORDS

CASING RECORD

FORMATION	CONTENT	FROM	TO	SIZE	PUT IN	PULLED OUT
surface hole	shale	surf	1542	8-5/8"	1532	none

Describe in detail the manner in which the well was plugged, indicating where the mud fluid  
was placed and the method or methods used in introducing it into the hold. If cement or other  
plugs were used, state the character of same and depth placed, from feet to  
feet for each plug set.

Fluid to 3200', plug, 25 sx  
Fluid to 2800', plug, 25 sx  
Fluid to 1500, plug, 35 sx  
Fluid to 40', plug, 10 sx  
Rat hole 5 sx

RECEIVED  
STATE CORPORATION COMMISSION  
MAR 12 1979  
3-12-79  
CONSERVATION DIVISION  
Wichita, Kansas

(If additional description is necessary, use BACK of this sheet)  
Name of Plugging Contractor D.N.B. DRILLING, INC.  
515 R. H. Garvey Building  
Wichita, Kansas 67202

STATE OF Kansas COUNTY OF Sedgwick, ss.  
Ella Priess (employee of owner) or (owner or operator)  
of the above-described well, being first duly sworn on oath, says: That I have knowledge of  
the facts, statements, and matters herein contained and the log of the above-described well  
as filed and that the same are true and correct. So help me God.

(Signature) Ella Priess  
Suite 515, R.H. Garvey Bldg., Wichita, Ks. 67202  
(Address)

SUBSCRIBED AND SWORN TO before me this 16th day of February, 19 79

Dorothy L. Schmidt  
Dorothy L. Schmidt Notary Public.

My commission expires April 30, 1979

DOROTHY L. SCHMIDT  
STATE NOTARY PUBLIC  
Sedgwick County, Kansas  
My Appt. Exp. April 30, 1979

DRILLER'S LOG

NATIONAL OIL COMPANY  
No. 1 Bilbery  
G NW SW Sec. 18-29S-42W  
Stanton Co., Ks.

Commenced: 2-2-79  
Completed: 2-14-79

Surface Casing: 1532' of 8-5/8"  
cmtd w/400 sx 60-40 pozmix, 2% gel,  
c% cc; 200 sx common, 2% gel, 3% cc  
2-5-79

FORMATION

DEPTH

Surface Hole	0 - 1542
Shale	1542 - 3172
Lime & Shale	3172 - 5180
Shale & Lime	5180 - 5355
Lime & Shale	5355 - 5635 RTD

I do hereby certify that the foregoing statements are true and correct to the best of my knowledge and belief.

D N B DRILLING, INC.

*Ella Priess*  
Ella Priess

STATE OF KANSAS: ss:

Subscribed and sworn to before me this 16th day of February, 1979.

*Dorothy L. Schmidt*  
Dorothy L. Schmidt, Notary Public

DOROTHY L. SCHMIDT  
STATE NOTARY PUBLIC  
Sedgwick County, Kansas  
My Appt. Exp: April 30, 1979

RECEIVED  
STATE CORPORATION COMMISSION

MAR 12 1979  
3-12-79  
CONSERVATION DIVISION  
Wichita, Kansas