

STATE OF KANSAS
STATE CORPORATION COMMISSION


Give All Information Completely
Make Required Affidavit
Mail or Deliver Report to:
Conservation Division
State Corporation Commission
800 Bittling Building
Wichita, Kansas

WELL PLUGGING RECORD

Stanton Co. County. Sec. 33 Twp. 29S Rge. 43 ~~EX~~ (W)

Location as "NE/CNW/SW" or footage from lines C SE SW
Lease Owner J. M. Huber Corp.
Lease Name Stewart Well No. 1
Office Address Box 978, Liberal, Kansas
Character of Well (completed as Oil, Gas or Dry Hole) Dry Hole
Date well completed 10-13-55 19
Application for plugging filed 10-12-55 19
Application for plugging approved 10-12-55 19
Plugging commenced 10-13-55 19
Plugging completed 10-13-55 19
Reason for abandonment of well or producing formation Dry Hole

NORTH

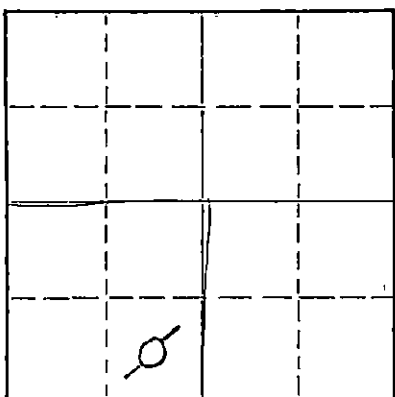

Locate well correctly on above Section Plat

If a producing well is abandoned, date of last production 19
Was permission obtained from the Conservation Division or its agents before plugging was commenced? Yes

Name of Conservation Agent who supervised plugging of this well M. A. Rives
Producing formation Depth to top Bottom Total Depth of Well 5606 Feet
Show depth and thickness of all water, oil and gas formations.

OIL, GAS OR WATER RECORDS

CASING RECORD

FORMATION	CONTENT	FROM	TO	SIZE	PUT IN	PULLED OUT
				8-5/8"	1640'	None

Describe in detail the manner in which the well was plugged, indicating where the mud fluid was placed and the method or methods used in introducing it into the hole. If cement or other plugs were used, state the character of same and depth placed, from feet to feet for each plug set.

Filled with mud to 600'. Pushed Halliburton plug to 600' with drill pipe and cemented thru pipe with 35 sacks of cement.

Filled with mud to 35'. Pushed Halliburton plug to 35' with 1/2 sack of hulls on top and filled to surface with 15 sacks of cement.

RECEIVED
STATE CORPORATION COMMISSION
OCT 25 1955
CONSERVATION DIVISION
Wichita, Kansas

(If additional description is necessary, use BACK of this sheet)
Name of Plugging Contractor D & M Drilling Co.
Address Wichita, Kansas

STATE OF KANSAS, COUNTY OF SEWARD, ss.
W. W. Henson (employee of owner) or (owner) of the above-described well, being first duly sworn on oath, says: That I have knowledge of the facts, statements, and matters herein contained and the log of the above-described well as filed and that the same are true and correct. So help me God.

(Signature) W. W. Henson
Box 978, Liberal, Kansas (Address)

SUBSCRIBED AND SWORN to before me this 24 day of October, 19 55

My commission expires 7-27-57. J. R. Keyler Notary Public.

PLUGGING
FILE SEC 33 T. 29. R. 43 W.
BOOK PAGE 8 LINE 20

STEWART #1

C SE/4 SW/4 of Section 33-29S-43W Stanton County, Kansas

Rigged up Rotary Tools 9/8/55

Ran 41 Jts. (1640') 8 5/8" Weld Pipe set at 1640'. Cemented with 750 sacks Posmix, 2% CC

Tore down Rotary Tools 10/12/55

FORMATION	FROM	TO
Clay	0'	40'
Clay & sand	40	185
Shale & sand	185	376
Sand	376	531
Redbed	531	677
Redbed, shells & salt	677	962
Redbed & shells	962	1135
Redbed, shells & anhydrite	1135	1224
Shells & shale	1224	1592
Redbed & shells	1592	1725
Anhydrite & shells	1725	1737
Shells & shale	1737	2335
Shale w/lime streaks	2335	2600
Shale, lime & sand	2600	2835
Sandy lime & shale	2835	2907
Shale w/sand streaks	2907	2978
Shale & sand	2978	3120
Sandy shale	3120	3180
Lime	3180	3415
Lime & chert	3415	3511
Lime, chert & chalk	3511	3573
Lime & chert	3573	3685
Lime	3685	3764
Lime & shale	3764	3843
Lime	3843	3900
Lime w/shale streaks	3900	3935
Lime & shale	3935	4025
Lime w/shale streaks	4025	4064
Lime & shale	4064	4102
Lime	4102	4141
Shale & lime	4141	4280
Lime	4280	4404
Lime & shale	4404	4435
Lime w/shale streaks	4435	4480
Lime & shale	4480	4570
Lime, sand & shale	4570	4616
Lime & shale	4616	4641
Lime	4641	4688
Lime & shale	4688	4735
Lime & shale	4735	4773
Lime	4773	4838
Shale w/lime streaks	4838	4903
Lime & shale	4903	5178
Shale	5178	5291
Lime	5291	5300
Lime & shale	5300	5337
Sandy lime	5337	5365
Shale & sand	5365	5606 T.D.

I, Don S. Packer, do hereby certify that the foregoing log is true and correct, to the best of my knowledge and belief.

Don S. Packer

 Notary Public

Subscribed and sworn to before me this 14th day of October, 1955.

PLUGGING
 sec 33-29S-43W
 My Commission Expires: July 29, 1957
 PAGE 2 LINE 20

RECEIVED
 STATE CORP. REG. DIVISION
 OCT 25 1955

CONSERVATION DIVISION
 WICHITA, KANSAS

10-25-55