

This form shall be filed in duplicate with the Kansas Corporation Commission, 200 Colorado Derby Building, Wichita, Kansas 67202, within ten days after the completion of the well, regardless of how the well was completed.

Attach separate letter of request if the information is to be held confidential. If confidential, only file one copy. Information on side one will be of public record and side two will then be held confidential.

Circle one: (Oil) Gas, Dry, SWD, OWWO, Injection. Type and complete ALL sections.

Applications must be filed for dual completion, commingling, SWD and injection, T.A.

Attach wireline logs (i.e. electrical log, sonic log, gamma ray neutron log, etc.).

KCC # (316) 263-3238. (Rules 82-2-105 & 82-2-125)

OPERATOR Glacier Petroleum Company, Inc.

API NO. 15-073-22,328 - 06 00

ADDRESS P. O. Box 577

COUNTY Greenwood

Emporia, Kansas 66801

FIELD _____

**CONTACT PERSON J. C. Hawes

PROD. FORMATION Viola

PHONE 316-342-1148

LEASE Smith

PURCHASER Inland

WELL NO. 3

ADDRESS Wichita, Kansas

WELL LOCATION NW SW SE

DRILLING CONTRACTOR Glacier Drilling Company, Inc.

_____ Ft. from _____ Line and

ADDRESS P. O. Box 1509


_____ Ft. from _____ Line of

Emporia, Kansas 66801

the SEC. 7 TWP. 25S RGR. 11E

WELL PLAT

PLUGGING CONTRACTOR ADDRESS _____

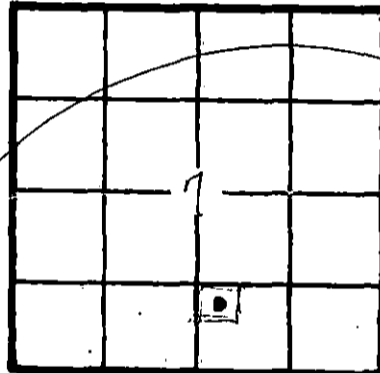

KCC _____
KGS _____
(Office Use)

TOTAL DEPTH 2399' GL PBTD 2400' GL

SPUD DATE 04-24-82 DATE COMPLETED 04-30-82

ELEV: GR 1142 DF _____ KB _____

DRILLED WITH (CABLE) (ROTARY) (AIR) TOOLS

Amount of surface pipe set and cemented 106.87' DV Tool Used? _____

AFFIDAVIT

STATE OF Kansas, COUNTY OF Lyon SS, I, _____

J. C. Hawes OF LAWFUL AGE, BEING FIRST DULY SWORN UPON HIS OATH,

DEPOSES THAT HE IS Vice-President (FOR)(OF) Glacier Petroleum Company, Inc.

OPERATOR OF THE Smith LEASE, AND IS DULY AUTHORIZED TO MAKE

THIS AFFIDAVIT FOR AND ON THE BEHALF OF SAID OPERATOR, THAT WELL NO. 3 ON

SAID LEASE HAS BEEN COMPLETED AS OF THE 7th DAY OF July, 1982, AND THAT

ALL INFORMATION ENTERED HEREIN WITH RESPECT TO SAID WELL IS TRUE AND CORRECT.

FURTHER AFFIANT SAITH NOT.

(S) _____

SUBSCRIBED AND SWORN BEFORE ME THIS 8th DAY OF July, 1982

ETHEL M. GRIMWOOD
Lyon County, Ks.
My Appt. Exp. 2-18-84

Ethel M. Grimwood
STATE CORPORATION COMMISSION

MY COMMISSION EXPIRES: _____

NOTARY PUBLIC AUG 24 1983

**The person who can be reached by phone regarding any questions concerning this information. Within 45 days of completion, a witnessed initial test by the Commission is required if the well produces more than 25 MOPD or is located in a Basic Order Pool.

SIDE TWO

WELL LOG

Show all important zones of porosity and contents thereof; corrod intervals, and all drill-stem tests, including depth interval tested, cushion used, time tool open, flowing and shut-in pressures, and recoveries.

SHOW GEOLOGICAL MARKERS, LOGS RUN, OR OTHER DESCRIPTIVE INFORMATION.

FORMATION DESCRIPTION, CONTENTS, ETC.	TOP	BOTTOM	NAME	DEPTH
Soil	0	8		
Clay	8	15		
Shale	15			
Lime	49			
Shale	70			
Shale	115	458		
Lime	458	470		
Shale	470	482		
Lime	482	506		
Shale	506	871		
Lansing Lime	871	920		
Shale w/lime	920	958		
Lime	958	998		
Shale w/lime	998	1060		
Shale w/lime	1060	1150		
K. C.	1150	1362		
Base K.C.	1362			
Altamont	1483			
Pawnee	1512			
Fort Scott	1586			
Cherokee	1660			
Mississippi	2008			
Arbuckle	2396	TD 2399		

Report of all strings set—surface, intermediate, production, etc. CASING RECORD (New) or (Used)

Purpose of string	Size hole drilled	Size casing set (in O.D.)	Weight lbs/ft.	Setting depth	Type cement	Secks	Type and percent additives
Surface	12 1/2"	8-5/8"		106.87'	Common	45	3% CC
Production	7-7/8"	5 1/2"		2395.00'	Common	75	2% Gel

LINER RECORD

PERFORATION RECORD

Top, ft.	Bottom, ft.	Secks cement	Shots per ft.	Size & type	Depth interval

Size	Setting depth	Packer set at

ACID, FRACTURE, SHOT, CEMENT SQUEEZE RECORD

Amount and kind of material used	Depth interval treated

Date of first production	Producing method flowing, pumping, gas lift, etc.	Gravity
7/7/82		
RATE OF PRODUCTION PER 14 HOURS	Oil	Gas
	bbbl	MCF
Water	70	Gas-oil ratio
	bbbl	CPS
Disposition of gas (vented, used on lease or sold)	Perforations	