


STATE OF KANSAS
STATE CORPORATION COMMISSION

WELL PLUGGING RECORD

Give All Information Completely
Make Required Affidavit
Mail or Deliver Report to:
Conservation Division
State Corporation Commission
211 No. Broadway
Wichita, Kansas

KINGMAN County. Sec. 16 Twp. 29 Rge. 9 (X) W (W)
Location as "NE/CNW/SW" or footage from lines NW NE NE
Lease Owner PETROLEUM INC.
Lease Name MILLER "H" Well No. 1
Office Address Route 2, Great Bend, Kansas
Character of Well (completed as Oil, Gas or Dry Hole) Dry Hole
Date well completed March 13 1957
Application for plugging filed March 13 1957
Application for plugging approved March 13 1957
Plugging commenced March 12 1957
Plugging completed March 13 1957
Reason for abandonment of well or producing formation No producible zones

NORTH

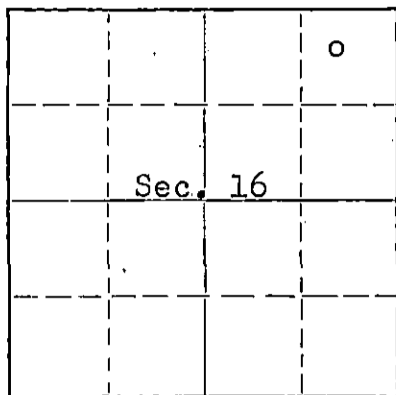

Locate well correctly on above
Section Plat

If a producing well is abandoned, date of last production None 19
Was permission obtained from the Conservation Division or its agents before plugging was commenced? Yes

Name of Conservation Agent who supervised plugging of this well M. A. Rives, Box 8, Pratt, Kansas
Producing formation ----- Depth to top ----- Bottom ----- Total Depth of Well 4471 Feet
Show depth and thickness of all water, oil and gas formations.

OIL, GAS OR WATER RECORDS

CASING RECORD

FORMATION	CONTENT	FROM	TO	SIZE	PUT IN	PULLED OUT
				8 5/8" OD	247'	None

Describe in detail the manner in which the well was plugged, indicating where the mud fluid was placed and the method or methods used in introducing it into the hole. If cement or other plugs were used, state the character of same and depth placed, from feet to feet for each plug set.

Mud up with heavy mud to 235', pushed down 1/4 sack hulls to 235' followed by wooden plug. Placed 20 sacks cement through drill pipe on to plug. Mud up to 35' and place 1/4 sack hulls at 35' followed by wooden plug and 10 sacks cement to base of well cellar.

(If additional description is necessary, use BACK of this sheet)

Name of Plugging Contractor Garvey Drilling Company
Address Route 2, Great Bend, Kansas

STATE OF KANSAS, COUNTY OF BARTON, ss.
DON SEARLE (employee of owner) or (owner or operator) of the above-described well, being first duly sworn on oath, says: That I have knowledge of the facts, statements, and matters herein contained and the log of the above-described well as filed and that the same are true and correct. So help me God.

(Signature) Don Searle
Route 2, Great Bend, Kansas
(Address)

SUBSCRIBED AND SWORN TO before me this 18th day of March, 1957
Richard L. Brown
Notary Public.

My commission expires July 11, 1960

PLUGGING
FILE SEC 16 T 29 R 9W
BOOK PAGE 147 LINE 45

STATE CORPORATION COMMISSION
MAR 15 1957
CONSERVATION DIVISION
Wichita, Kansas

WELL LOG

COMPANY PETROLEUM, INCORPORATED

SEC. 16 T. 29S R. 9W

FARM MILLER 'H' NO. 1


LOC. NW, NE, NE

TOTAL DEPTH 4471'

COUNTY Kingman Co., Kansas

COMM. February 26, 1957 COMP. March 12, 1957

CONTRACTOR GARVEY DRILLING COMPANY

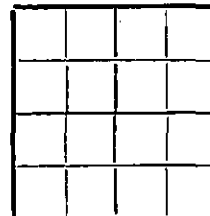

CASING 8 5/8" @ 247' w/200 sax.

ELEVATION 1649' DF

PRODUCTION D & A.

FIGURES INDICATE BOTTOM OF FORMATIONS

247	Red rock & shale		
825	Red rock, red bed & shale		
1330	Shale & shells		
1347	Anhydrite	Anhydrite	1330
3235	Shale & lime	Heebner	3347
3288	Lime	Toronto	3365
3372	Lime & shale	Doug. shale	3379
3465	Lime, shale & sand	Doug. sand	3425
3535	Shale	Lansing	3551
3542	Sand	Mississippi	4187
4120	Lim@		
4187	Lime & shale		
4253	Mississippi chert		
4300	Lime		
4355	Shale & lime		
4445	Shale & chert		
4465	Shale		
4471	Lime		
4471	T. D.		

State of KANSAS }
County of BARTON } ss:

RECEIVED
STATE CORPORATION COMMISSION

MAR 19 1957

CONSERVATION DIVISION
Wichita, Kansas

PLUGGING
FILE SEC. 16 T. 29 R. 9W
BOOK PAGE 147 LINE 45

I, Verne A. Morris of Garvey Drilling Co.

upon oath state that the above and foregoing is a true and correct copy of the log of the #1 Miller 'H' well

Verne A. Morris

Subscribed and sworn to before me this 18th day of March 19 57

My Commission Expires: July 11, 1960

[Signature]
NOTARY PUBLIC