


STATE OF KANSAS
STATE CORPORATION COMMISSION
CONSERVATION DIVISION
P. O. BOX 17027
WICHITA, KANSAS 67217

FORM CP-4

WELL PLUGGING RECORD

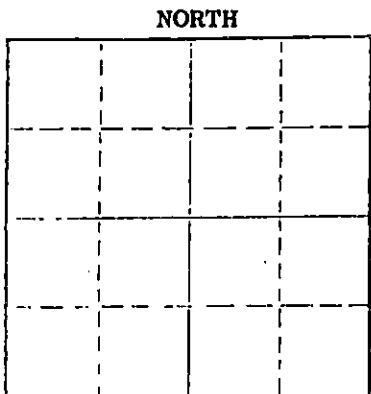

Locate well correctly on above Section Plat

Kingman County, Sec. 16 Twp. 29S Rge. 9W (E8) (W)
Location as "NE/CNW/SE/SW" or footage from lines NW SW NW
Lease Owner Little George Oil Co.
Lease Name Schneider Well No. 2
Office Address Suite 225, Sutton Place, Wichita, Ks. 67202
Character of Well (completed as Oil, Gas or Dry Hole) Dry Hole
Date well completed February 22 19 76
Application for plugging filed February 22 19 76
Application for plugging approved February 22 19 76
Plugging commenced February 22 19 76
Plugging completed February 22 19 76
Reason for abandonment of well or producing formation Dry Hole

If a producing well is abandoned, date of last production 19
Was permission obtained from the Conservation Division or its agents before plugging was commenced? yes

Name of Conservation Agent who supervised plugging of this well G. L. Bieberstein
Producing formation Depth to top Bottom Total Depth of Well 4712 Feet
Show depth and thickness of all water, oil and gas formations.

OIL, GAS OR WATER RECORDS

CASING RECORD

FORMATION	CONTENT	FROM	TO	SIZE	PUT IN	PULLED OUT

Describe in detail the manner in which the well was plugged, indicating where the mud fluid was placed and the method or methods used in introducing it into the hole. If cement or other plugs were used, state the character of same and depth placed, from feet to feet for each plug set.

Bottom plug @ 250' w/35 sacks cement thru drill pipe.
~~XXXXXXXXXXXX~~ Top plug @ 40' w/15 sacks cement thru drill pipe.
2 sacks cement in rat hole.

RECEIVED
CONSERVATION COMMISSION

FEB 24 1976

CONSERVATION DIVISION
Wichita, Kansas

(If additional description is necessary, use BACK of this sheet)
Name of Plugging Contractor Duke Drilling Co.
Address Box 823, Great Bend, Kansas 67530

STATE OF KANSAS COUNTY OF BARTON
Larry Curtis

(employee of owner) or (XXXXXXXXXXXX) of the above-described well, being first duly sworn on oath, says: That I have knowledge of the facts, statements, and matters herein contained and the log of the above-described well as filed and that the same are true and correct. So help me God.

(Signature)

Larry Curtis

Box 823, Great Bend, Ks. 67530

(Address)

SUBSCRIBED AND SWORN TO before me this 23rd day of February 19 76

My commission expires April 11, 1978

Harold M. Hague
Notary Public.

DRILLERS' WELL LOG

DATE COMMENCED: February 11, 1976
DATE COMPLETED: February 22, 1976

Little George Oil Co.
SCHNEIDER # 2
NW SW NW
Sec. 16-T29S-R9W
Kingman County, Kansas

0 - 268'	Sand, Red Bed
268 - 1399'	Red Bed, Shale
1399 - 1415'	Anhydrite
1415 - 2976'	Shale and Lime
2976 - 3411'	Lime
3411 - 3419'	Shale
3419 - 3439'	Shale and Lime
3439 - 3610'	Shale
3610 - 3619'	Lime and Shale
3619 - 4056'	Lime
4056 - 4253'	Lime and Shale
4253 - 4316'	Chert
4316 - 4512'	Sand
4512 - 4580'	Chert, Shale
4580 - 4697'	Sand, Lime, Shale
4697 - 4712'	Dolomite
4712'	RTD

ELEVATION: 1704 K.B.

FORMATION TOPS

Anhydrite	1399
Topeka	2976
Heebner	3411
Douglas	3439
Brown Lime	3610
Lansing	3619
Stark	3962
Base K.C.	4056
Mississippi	4253
Kinderhook	4316
Viola	4512
Simpson	4580
Arbuckle	4697
RTD	4712

SURFACE PIPE:

Set used 8 5/8", 28# pipe @ 268'
w/200 sacks Common, 2% Gel, 3% cc.

A F F I D A V I T

STATE OF KANSAS)
COUNTY OF BARTON) ss.

Larry Curtis, of lawful age, does swear and state that the facts and statements herein contained are true and correct to the best of his knowledge.

Larry Curtis

Subscribed and sworn to before me this 23rd day of February, 1976.

Shirley M. Hague
Notary Public

My Commission Expires: April 11, 1978

RECEIVED
STATE COMMISSION

FEB 24 1976

CONSERVATION DIVISION
Wichita, Kansas