


WELL PLUGGING RECORD

Give All Information Completely  
Make Required Affidavit  
Mail or Deliver Report to:  
Conservation Division  
State Corporation Commission  
211 No. Broadway  
Wichita, Kansas

NORTH

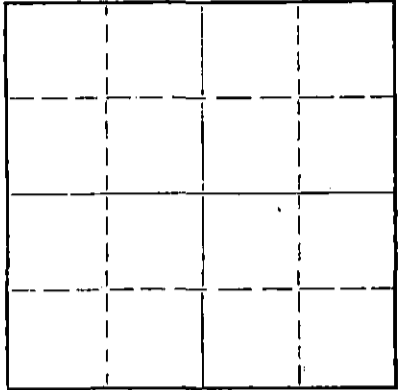

Locate well correctly on above Section Plat

Kingman County, Sec. 18 Twp. 29S Rge. 9W (~~EXX~~) (W)  
Location as "NE/CNW/SW" or footage from lines C SW NE  
Lease Owner E. K. Edmiston and R. W. Shields  
Lease Name SCHUMAN Well No. 1  
Office Address 501 First National Bank Building, Wichita, Kansas  
Character of Well (completed as Oil, Gas or Dry Hole) dry hole  
Date well completed January 3, 1964 19  
Application for plugging filed January 2, 1964 19  
Application for plugging approved January 3, 1964 19  
Plugging commenced January 3, 1964 19  
Plugging completed January 3, 1964 19  
Reason for abandonment of well or producing formation dry hole

If a producing well is abandoned, date of last production --- 19  
Was permission obtained from the Conservation Division or its agents before plugging was commenced? yes

Name of Conservation Agent who supervised plugging of this well Archie V. Elving  
Producing formation --- Depth to top --- Bottom --- Total Depth of Well 4730 Feet  
Show depth and thickness of all water, oil and gas formations.

OIL, GAS OR WATER RECORDS

CASING RECORD

FORMATION	CONTENT	FROM	TO	SIZE	PUT IN	PULLED OUT
				8-5/8"	272'	

Describe in detail the manner in which the well was plugged, indicating where the mud fluid was placed and the method or methods used in introducing it into the hole. If cement or other plugs were used, state the character of same and depth placed, from --- feet to --- feet for each plug set.

plugged at 265' with hulls and 25 sacks cement,  
filled hole to 40' and plugged with hulls and 10 sacks  
cement.

RECEIVED  
STATE CORPORATION COMMISSION

1-9-64 JAN 9 1964

CONSERVATION DIVISION  
Wichita, Kansas

(If additional description is necessary, use BACK of this sheet)

Name of Plugging Contractor E. K. Edmiston Drilling Co., Inc.  
Address 501 First National Bank Building, Wichita, Kansas

STATE OF Kansas, COUNTY OF Sedgwick, ss.  
E. K. Edmiston, one of the owners (~~operator~~) of the above-described well, being first duly sworn on oath, says: That I have knowledge of the facts, statements and matters herein contained and the log of the above-described well as filed and that the same are true and correct. So help me God.


(Signature) [Signature]

501 First National Bank Building, Wichita,  
(Address) Ks.

SUBSCRIBED AND SWORN TO before me this 7th day of January, 19 64

My commission expires August 25, 1964

A. B. Barger  
Notary Public.

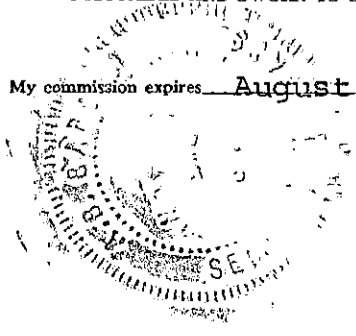

DRILLER'S LOG

Company: E. K. Edmiston  
and  
R. W. Shields  
501 First National Bank Building  
Wichita, Kansas

Rotary Drilling Commenced: December 15, 1963

Rotary Drilling Completed: January 3, 1964

Well Name: SCHUMAN No. 1  
C SW NE Section 18-29S-9W  
Kingman County, Kansas

Contractor: E. K. Edmiston Drilling Co., Inc.  
501 First National Bank Building  
Wichita, Kansas

Casing record: 8-5/8" at 272' with 200 sacks cement

L O G

Measurements from top of Rotary Bushing

Sand	30
Clay	40
Sand	272
Red Bed	850
Shale and Shells	1320
Lime and Shale	2125
Lime	2190
Lime and Shale	3390
Lime	3510
Lime and Shale	3630
Lime	4228
Mississippi	4270
Lime	4303
Lime and Shale	4446
Shale	4531
Viola	4638
Simpson	4695
Arbuckle	4730 RTD

RECEIVED  
STATE CORPORATION COMMISSION

JAN 9 1964

CONSERVATION DIVISION  
Wichita, Kansas

The undersigned, E. K. Edmiston, President of E. K. Edmiston Drilling Co., Inc., hereby certifies, on behalf of said company, that the above log is a true and correct log of the formations encountered in drilling the above well as reflected by the daily drilling reports.

E. K. EDMISTON DRILLING CO., INC.

By E. K. Edmiston  
E. K. Edmiston, President

STATE OF KANSAS,

SS:

SEDGWICK COUNTY,

BE IT REMEMBERED that on this 7th day of January, 1964, before me, the undersigned, a Notary Public duly commissioned in and for the county and state aforesaid, came E. K. Edmiston, known to me to be the same person who executed the foregoing instrument as President and on behalf of the E. K. Edmiston Drilling Co., Inc., and he duly acknowledged the execution of the same for himself and for said company.

IN WITNESS WHEREOF, I have hereunto set my hand and official seal on the day and year last above written.

My commission expires  
August 25, 1964

A. B. Bergen  
A. B. Bergen, Notary Public