

STATE OF KANSAS
STATE CORPORATION COMMISSION

All Information Completely
Make Required Affidavit
Mail or Deliver Report to:
Conservation Division
State Corporation Commission
211 No. Broadway
Wichita, Kansas

WELL PLUGGING RECORD

Kingman County, Sec. 21 Twp. 29S Rge. 9W (E) (W)

Location as "NE/CNW%SW%" or footage from lines C NE SE

Lease Owner: Leben Drilling, Inc.

Lease Name: Gillen Well No. 1

Office Address: 905 Central Bldg., Wichita, Kansas

Character of Well (completed as Oil Gas or Dry Hole) Dry Hole

Date well completed 6-18-59 19

Application for plugging filed 6-18-59 19

Application for plugging approved 6-18-59 19


Plugging commenced 6-18-59 19

Plugging completed 6-18-59 19

Reason for abandonment of well or producing formation Dry Hole

If a producing well is abandoned, date of last production 19

Was permission obtained from the Conservation Division or its agents before plugging was commenced? Yes

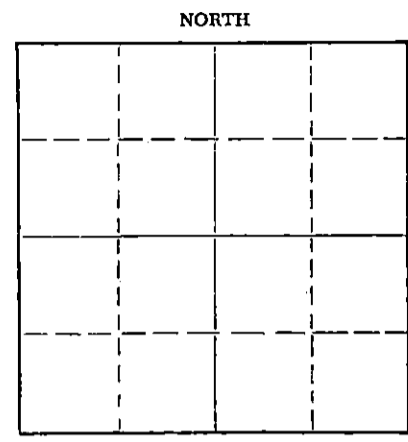

Locate well correctly on above Section Plat

Name of Conservation Agent who supervised plugging of this well Fred Hampel

Producing formation _____ Depth to top _____ Bottom _____ Total Depth of Well 4505 Feet

Show depth and thickness of all water, oil and gas formations.

OIL, GAS OR WATER RECORDS

CASING RECORD

FORMATION	CONTENT	FROM	TO	SIZE	PUT IN	PULLED OUT
				8 5/8	258'	

Describe in detail the manner in which the well was plugged, indicating where the mud fluid was placed and the method or methods used in introducing it into the hole. If cement or other plugs were used, state the character of same and depth placed, from _____ feet to _____ feet for each plug set.

1st plug @ 240' w/ 18 sx. common cement.
Top plug @ 40' w/ 10 sx. common cement.

RECEIVED
STATE CORPORATION COMMISSION

JUN 26 1959

CONSERVATION DIVISION
Wichita, Kansas

(If additional description is necessary, use BACK of this sheet)
Name of Plugging Contractor Leben Drilling, Inc.
Address 905 Central Bldg., Wichita, Kansas

STATE OF KANSAS, COUNTY OF SEDGWICK, ss.
Frank Hamlin (employee of owner) or (owner or operator) of the above-described


well, being first duly sworn on oath, says: That I have knowledge of the facts, statements, and matters herein contained and the log of the above-described well as filed and that the same are true and correct. So help me God.

(Signature) Frank Hamlin
905 Central Bldg., Wichita, Kansas
(Address)

SUBSCRIBED AND SWORN TO before me this 22nd day of June, 1959

My commission expires April 23, 1963

Juanita M. Green
Juanita M. Green Notary Public.

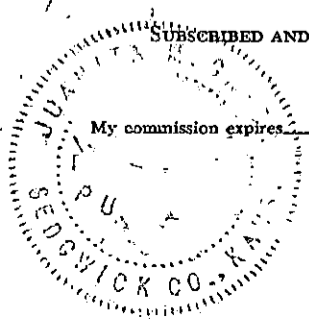

PLUGGING
FILE SEC. 21 T. 29 R. 9W
BOOK PAGE 59 LINE 39

DRILLER'S LOG

COMPANY:
CONTRACTOR:
FARM:
LOCATION:

COMMENCED:
COMPLETED:

LEBEN DRILLING, INC.
LEBEN DRILLING, INC.
GILLEN #1
Q NE SE SECTION 21-29S-9W
KINGMAN COUNTY, KANSAS
6-5-59
6-18-59

0	50	Sand
50	150	Shale & Shells
130	1405	Shale & Shells
1405	1610	Lime & Shells
1610	1775	Lime
1775	2015	Lime
2015	2160	Lime
2160	2400	Shale & Lime
2400	2745	Lime & Shale
2745	3195	Lime & Shale
3195	3215	Lime
3215	3315	Lime & Shale
3315	3575	Lime & Shale
3575	3631	Lime
3631	3800	Lime
3800	4025	Lime
4025	4070	Lime & Shale
4070	4203	Lime
4203	4203	Chert
4208	4265	Cherty Lime
4265	4280	Lime & Chert
4280	4325	Lime
4325	4505	Lime & Shale
	4505	Rotary Total Depth

RECEIVED
STATE CORPORATION COMMISSION
JUN 26 1959
CONSERVATION DIVISION
Wichita, Kansas

Ran 8 5/8" surface casing @ 250' with 175 sacks cement (Sunset).

I, Frank Hamlin, do hereby certify that the above and foregoing is a true and correct copy of the log of the Gillen #1, located Q NE SE of Section 21, Township 29 South, Range 9 West, Kingman County, Kansas, as reflected by the files of Leben Drilling, Inc.

LEBEN DRILLING, INC.

By: Frank Hamlin
Frank Hamlin

STATE OF KANSAS)
COUNTY OF SEDGWICK) ss.

Subscribed and sworn to before me, a Notary Public, in and for Sedgwick County, Kansas, this 22nd day of June, 1959.

Juanita M. Green
Juanita M. Green, Notary Public

My commission expires:
April 25, 1963

PLUGGING
FILE SEC 21 T-29 R-9W
BOOK PAGE 59 LINE 39