


STATE OF KANSAS
STATE CORPORATION COMMISSION
CONSERVATION DIVISION
P. O. BOX 17027
WICHITA, KANSAS 67217

FORM CP-4

WELL PLUGGING RECORD

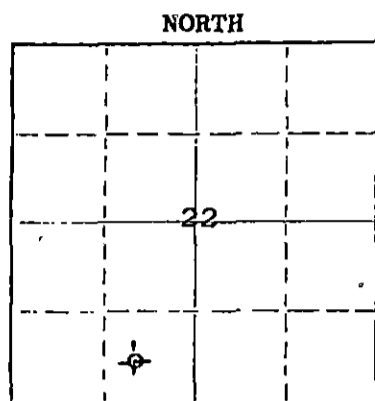

Locate well correctly on above Section Plot

Kingman County, Sec 22 Twp 29S Rge 9W (W)
Location as "NE/CNWSW" or footage from lines 200' W of C SE SW
Lease Owner D. R. Lauck Oil Company, Inc.
Lease Name Ricke Well No. 1
Office Address 301 S. Broadway, Wichita, Kansas 67202
Character of Well (completed as Oil, Gas or Dry Hole) Dry Hole
Date well completed March 6, 1976
Application for plugging filed March 6, 1976
Application for plugging approved March 6, 1976
Plugging commenced March 6, 1976
Plugging completed March 6, 1976
Reason for abandonment of well or producing formation Dry Hole

If a producing well is abandoned, date of last production _____ 19____
Was permission obtained from the Conservation Division or its agents before plugging was commenced? Yes

Name of Conservation Agent who supervised plugging of this well _____
Producing formation _____ Depth to top _____ Bottom _____ Total Depth of Well 4560 Feet
Show depth and thickness of all water, oil and gas formations.

OIL, GAS OR WATER RECORDS				CASING RECORD		
FORMATION	CONTENT	FROM	TO	SIZE	PUT IN	FULLED OUT
		0'	262'	8-5/8"	262'	None

Describe in detail the manner in which the well was plugged, indicating where the mud fluid was placed and the method or methods used in introducing it into the hole. If cement or other plugs were used, state the character of same and depth placed, from _____ feet to _____ feet for each plug set.

Spotted with 30 sacks cement at 240' and 15 sacks at 40', 2 sacks in rat hole.

RECEIVED
STATE CORPORATION COMMISSION
MAR 15 1976 3-15-76

(If additional description is necessary, use BACK of this sheet)
Name of Plugging Contractor Allied Cementing Co.
Address Great Bend, Kansas

CONSERVATION DIVISION
Wichita, Kansas

STATE OF KANSAS COUNTY OF SEDGWICK ss.
John D. Knightley (employee of owner) or (owner or operator) of the above-described

well, being first duly sworn on oath, says: That I have knowledge of the facts, statements, and matters herein contained and the log of the above-described well as filed and that the same are true and correct. So help me God.

(Signature) *John D. Knightley*
301 S. Broadway, Wichita, Kansas
(Address)

SUBSCRIBED AND SWORN TO before me this 12 th day of March, 1976

My commission expires March 12, 1979 Notary Public.

D. R. Lauck Oil Company, Inc. - Ricke #1
 200' W of C SE SW
 Sec. 22-29S-9W
 Kingman County, Kansas

Contractor: D. R. Lauck Oil Company, Inc.
 301 S. Broadway
 Wichita, Kansas 67202

Commenced: February 23, 1976
 Completed: March 6, 1976

Drillers Log

Clay & Shale	255
Shale & Shells	1300
Shale & Lime	1615
Lime & Shale	1805
Lime	2350
Sand	2390
Lime & Shale	2580
Lime	2985
Lime & Shale	3105
Lime	3325
Shale, Sand & Lime	3440
Lime & Shale	3545
Lime	3640
Lime & Shale	3750
Lime	4185
Chert	4201
Lime	4430
Lime & Chert	4520
Lime	4560 RTD

RECEIVED
 GENERAL INVESTIGATING DIVISION

MAR 15 1976

GENERAL INVESTIGATING DIVISION
 WICHITA, KANSAS