


15-095-00379-0000

STATE OF KANSAS  
STATE CORPORATION COMMISSION

WELL PLUGGING RECORD

Give All Information Completely  
Make Required Affidavit  
Mail or Deliver Report to:  
Conservation Division  
State Corporation Commission  
800 Bitting Building  
Wichita, Kansas

Kingman County. Sec. 24 Twp. 29 Rge. 9 (E) W (W)  
Location as "NE/CNW/SW" or footage from lines C N/2 NE SE  
Lease Owner Trans Era Petroleum, Inc.  
Lease Name Miller Well No. 1  
Office Address Russell, Kansas  
Character of Well (completed as Oil, Gas or Dry Hole) Dry Hole  
Date well completed 12/24/54 19  
Application for plugging filed 12/23/54 19  
Application for plugging approved 12/23/54 19  
Plugging commenced 12/24/54 19  
Plugging completed 12/24/54 19  
Reason for abandonment of well or producing formation Dry Hole

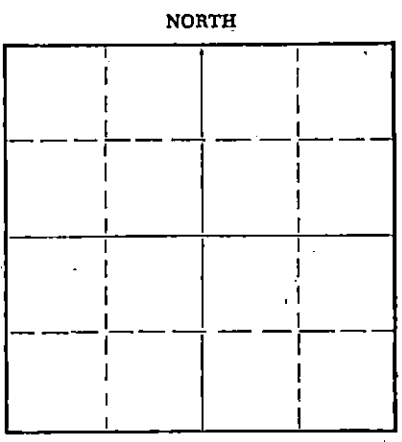

Locate well correctly on above  
Section Plat

If a producing well is abandoned, date of last production 19  
Was permission obtained from the Conservation Division or its agents before plugging was commenced? Yes

Name of Conservation Agent who supervised plugging of this well Ruel Durkee  
Producing formation \_\_\_\_\_ Depth to top \_\_\_\_\_ Bottom \_\_\_\_\_ Total Depth of Well 4730 Feet  
Show depth and thickness of all water, oil and gas formations.

OIL, GAS OR WATER RECORDS

CASING RECORD

FORMATION	CONTENT	FROM	TO	SIZE	PUT IN	PULLED OUT
				8 5/8	310	None

Describe in detail the manner in which the well was plugged, indicating where the mud fluid was placed and the method or methods used in introducing it into the hole. If cement or other plugs were used, state the character of same and depth placed, from \_\_\_\_\_ feet to \_\_\_\_\_ feet for each plug set.

PLUGGING RECORD

Lay down drill pipe. Filled hole with heavy mud to 250', set first plug at 250' with 15 sacks of cement used. Filled hole with mud to 20', set second plug at 20' with 5 sacks of cement used.

(If additional description is necessary, use BACK of this sheet)

Name of Plugging Contractor Trans Era Petroleum, Inc.  
Address Russell, Kansas

STATE OF KANSAS, COUNTY OF RUSSELL, ss.  
H. R. Michauds (employee of owner) or (owner or operator) of the above-described well, being first duly sworn on oath, says: That I have knowledge of the facts, statements, and matters herein contained and the log of the above-described well as filed and that the same are true and correct. So help me God.

(Signature) *H. R. Michauds*  
Russell, Kansas  
(Address)

SUBSCRIBED AND SWORN TO before me this 5th day of January, 1955

My commission expires 1-30-57

*Margie Cooper*  
Notary Public  
COMMISSION

PLUGGING  
FILE SEC 24 T 29 R 9W  
BOOK PAGE 89 LINE 11

1-7-55 JAN 7 - 1955  
CONSERVATION DIVISION  
Wichita, Kansas

Trans Era Petroleum, Inc.  
Miller #1

C N/2 NE SE 24-29-9  
Kingman County, Ks.

Total Depth: 4730'  
Comm. 12/5/54  
Comp. 12/24/54

Casing

8 5/8" Set @ 310'

Cement

225 sacks Lehigh

FORMATION	DEPTH
Clay	50
Red bed	80
Red bed-shale	160
Shale-shells	295
Red bed	460
Red bed-shale	740
Shale	995
Salt	1040
Shale	1170
Anhydrite	1600
Anhydrite-shale	1620
Shale-lime	1695
Lime	1990
Lime-shale	2920
Lime	3310
Lime-shale	3517
K.C. lime	3567
Lime	4075
Lime-shale	4130
Lime	4185
Lime-shale	4238
Lime	4385
Shale-lime	4514
Lime	4563
Sand	4612
Lime-shale	4635
Shale-sand	4670
Shale-lime	4680
Arbuckle	4730'

STATE OF KANSAS )  
                          ) ss  
RUSSELL COUNTY )

I hereby certify that the above information is true and correct to the best of my knowledge.

-----  
*Lena Betz*  
-----

Subscribed and sworn to before me this 5th day of January, 1955.

-----  
*Margie Cooper*  
-----  
Notary Public

My commission expires: 1-30-57.

PLUGGING  
JAN 24 1955  
NOTARY PUBLIC