


STATE OF KANSAS
STATE CORPORATION COMMISSION

WELL PLUGGING RECORD

Give All Information Completely
Make Required Affidavit
Mail or Deliver Report to
Conservation Division
State Corporation Comm.
245 North Water
Wichita, KS 67202

Kingman County, Sec. 28 Twp. 29S Rge. 9 E/W
Location as "NE/CNW 1/4 SW 1/4" or footage from lines
1980' FNL & 560' FEL
Lease Owner TEXAS OIL & GAS CORP.
Lease Name Bock "B" Well No. 1
Office Address 200 W. Douglas, Suite 300, Wichita KS 67202
Character of Well (Completed as Oil, Gas or Dry Hole)
Dry Hole
Date Well completed 4-30-77 19
Application for plugging filed 4-30-77 19
Application for plugging approved 4-30-77 19
Plugging commenced 4-30-77 19
Plugging completed 4-30-77 19
Reason for abandonment of well or producing formation

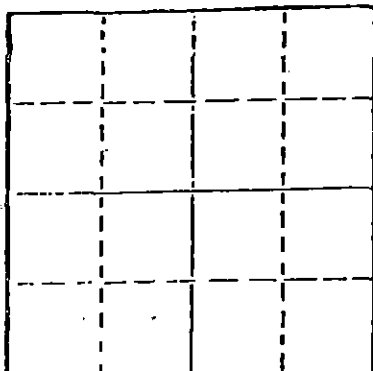

Locate well correctly on above
Section Plat

If a producing well is abandoned, date of last production 19

Was permission obtained from the Conservation Division or
its agents before plugging was commenced? Yes

Name of Conservation Agent who supervised plugging of this well Dwane Ranken Gt. Bend KS
Producing formation Depth to top Bottom Total Depth of Well
Show depth and thickness of all water, oil and gas formations.

OIL, GAS OR WATER RECORDS

CASING RECORD

FORMATION	CONTENT	FROM	TO	SIZE	PUT IN	PULLED OUT
		0	262'	8 5/8"	X	

Describe in detail the manner in which the well was plugged, indicating where the mud fluid
was placed and the method or methods used in introducing it into the hold. If cement or other
plugs were used, state the character of same and depth placed, from _____ feet to
_____ feet for each plug set.

Heavy mud from TD to 240' 35 sack cement plug
mud to 40' 1/2 sack hulls plug bridge 15 sacks base
of cellar 5 sacks rat hole.

RECEIVED
STATE CORPORATION COMMISSION
MAY 04 1977

CONSERVATION DIVISION
Wichita, Kansas

(If additional description is necessary, use BACK of this sheet)

Name of Plugging Contractor XPLOR DRILLING CO.


STATE OF KANSAS COUNTY OF SEDGWICK, ss.
Wayne L. Kirkman (owner or operator)
of the above-described well, being first duly sworn on oath, says: That I have knowledge of
the facts, statements, and matters herein contained and the log of the above-described well
as filed and that the same are true and correct. So help me God.

(Signature) Wayne L. Kirkman
180 S. Rock Road, Suite 300, Wichita KS 67207
(Address)

SUBSCRIBED AND SWORN TO before me this 2nd. day of May, 1977

Virginia Lee Smith
Virginia Lee Smith, Notary Public.

My commission expires August 25, 1980

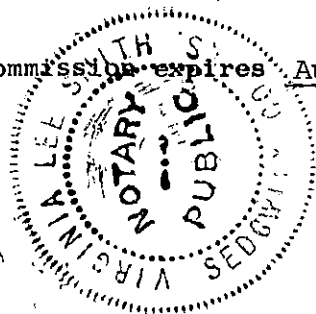

WELL LOG

BOCK "B" #1
 1980' FNL & 560' FEL
 Section 28-29S-9W
 Kingman County, Kansas

OPERATOR: TEXAS OIL & GAS CORP.
 CONTRACTOR: XPLOR DRILLING CO.

COMMENCED: 4-25-77
 COMPLETED: 4-30-77

CASING RECORD: Ran 6 jts. new 24" 8 5/8" set @262', cement with 250 sacks common, 2% gel. 3% cal.chloride.

<u>FORMATION</u>	<u>FROM</u>	<u>TO</u>	<u>ELEVATION</u>
Surface Soil	0	40	1648 GR.
Red Bed	40	1350	1653 D.F.
Red Bed & Lime	1350	2245	1656 K.B.
Shale & Lime	2245	2995	
RTD	2995		

RECEIVED
 STATE CORPORATION COMMISSION
 MAY 04 1977

CONSERVATION DIVISION
 Wichita, Kansas

STATE OF KANSAS)
) SS:
 COUNTY OF SEDGWICK)

I certify that this is a true and correct copy of the Driller's Log of the well drilled 1980' FNL & 560' FEL in Section 28-29S-9W, Kingman County, Kansas, to the best of my knowledge and belief.

XPLOR DRILLING CO.

Wayne L. Kirkman

 Wayne L. Kirkman, Owner

Subscribed and sworn to before me this 2nd. day of May 1977.

MY COMMISSION EXPIRES:
 August 25, 1980

Virginia Lee Smith

 Virginia Lee Smith, Notary Public

