


STATE OF KANSAS
STATE CORPORATION COMMISSION
CONSERVATION DIVISION
P. O. BOX 17027
WICHITA, KANSAS 67217

FORM CP-4

WELL PLUGGING RECORD

Kingman County. Sec. 28 Twp. 29 Rge. 9 (E) (W)

Location as "NE/CNW2SW" or footage from lines. C NE SE
Lease Owner Rex & Morris Drilling Company
Lease Name Goetz #1 Well No. 1
Office Address El Dorado, Kansas
Character of Well (completed as Oil, Gas or Dry Hole) GAS
Date well completed 9 MARCH 19 70
Application for plugging filed 21 JUNE 19 76
Application for plugging approved 22 JUNE 19 76
Plugging commenced 6/28/76 19
Plugging completed 7/ 8/76 19
Reason for abandonment of well or producing formation depleted.

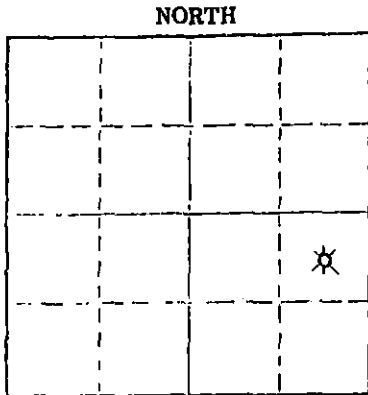

Locate well correctly on above Section Plot

If a producing well is abandoned, date of last production 25 JUNE 19 76
Was permission obtained from the Conservation Division or its agents before plugging was commenced? YES

Name of Conservator Agent who supervised plugging of this well Biberstein
Producing formation HOWARD LIMESTONE Depth to top 2828' Bottom 2839' Total Depth of Well 4545'
Show depth and thickness of all water, oil and gas formations.

OIL, GAS OR WATER RECORDS

CASING RECORD

FORMATION	CONTENT	FROM	TO	SIZE	PUT IN	PULLED OUT
				8-5/8	275	none
				4 1/2"	3072	2479'

Describe in detail the manner in which the well was plugged, indicating where the mud fluid was placed and the method or methods used in introducing it into the hole. If cement or other plugs were used, state the character of same and depth placed, from _____ feet to _____ feet for each plug set.

Sanded to 2600' and set 4 sacks cement. Loaded hole with water, shot pipe at 2550', 2485', pulled 77 joints of 4 1/2" casing. Pumped 2 sacks EVIDENCED
hulls, 10 sacks gel and 100 sacks cement. STATE CORPORATION COMMISSION

PLUGGING COMPLETE. JUL 16 1976 7-16-76

CONSERVATION DIVISION
Wichita, Kansas

Name of Plugging Contractor VOTH CASING PULLING
Address CHASE, KANSAS

STATE OF KANSAS, COUNTY OF RICE, ss. WALTER VOTH (employee of owner) or (owner or operator) of the above-described

well, being first duly sworn on oath, says: That I have knowledge of the facts, statements, and matters herein contained and the log of the above-described well as filed and that the same are true and correct. So help me God.

(Signature) Walter Voth
CHASE, KANSAS

SUBSCRIBED AND SWORN TO before me this 13th day of July, 19 76

My commission expires MARGARET MELCHER
Notary Public
Rice County, Ks.
My Comm. Exp. Feb. 15, 1979

Margaret Melcher
Notary Public

15-095-20200-0000

W. H. REX

J. E. MORRIS

REX & MORRIS DRILLING COMPANY

625 SOUTH MAIN

PHONE DAVIS 1-3800

P. O. BOX 334

EL DORADO, KANSAS

25 May 1976

Mr. Vincent Goetz
RFD
Zenda, Kansas 67159

Re: Goetz Gas Well No. 1
NE SE, 28-29S-9W
Kingman County, Kansas

Mr. Goetz:

In accordance with our telephone conversation at 9:15 AM, May 25, 1976, your signature on this letter will acknowledge that you have been given notice by Rex & Morris Drilling Company of their intent to plug and abandon the above gas well located on your land in Kingman County, Kansas, that you do not object to our plugging and abandoning the well and that you do not wish to purchase the well and equipment.

Please date and sign the original and the first carbon copy of this letter, and return them to us in the enclosed envelope at your earliest convenience. The third copy of the letter is for your files.

Very truly yours

Rex & Morris Drilling Company

A. H. Fisher
A. H. Fisher

Acknowledged this 26 day of May, 1976

Signed *Vincent Goetz*
VINCENT GOETZ
ZENDA, KANSAS

RECEIVED
STATE OF KANSAS COMMISSION

JUN 22 1976

CONSERVATION DIVISION
Wichita, Kansas

C
O
P
Y

G O E T Z # 1

REX & MORRIS, ETAL

ELEVATION: 1664 RB
1659 GLTOTAL DEPTH: 4545' RB
CONTRACTOR: RED TIGER DRILLING CO.
COMMENCED: 2-12-1970
COMPLETED: 3-9-1970
INITIAL PROD.: 5000 MCFPDLOCATION: CENTER NE SE
SECTION 28-29S-9W
KINGMAN COUNTY, KANSASCASING RECORD:
8 5/8" OD SET AT 275' W/250 SACKS
4 1/2" OD SET AT 3072' W/100 SACKS

<u>FORMATION</u>	<u>DEPTH</u>
RED BED & SHELLS	280'
RED BED	550'
SHALE	990'
SHALE & SHELLS	1450'
LIME & SHALE	2855'
SANDY LIME	2926'
TCPEKA LIME	2943'
SANDY LIME	2955'
SHALE & LIME	4250'
LIME RTD	4545'

RIGGED UP DERRICK PULLING UNIT. RAN GAMMA RAY-SONIC
LOG. PERFORATED 2927'-2929' & 2932'-2936' WITH
4 JET SHOTS PER FOOT. ACIDIZED WITH 500 GALLONS
REGULAR MUD ACID.WORKOVER - 12-8-70 TO 12-10-70
RIGGED UP DERRICK UNIT & KILLED WELL. RAN GAMMA RAY & COLLAR
LOG. PERFORATED 2828'-2830' & 2837'-2839', 4 JET SHOTS PER
FOOT & SET BAKER BRIDGE PLUG AT 2860'. RAN TUBING & ACIDIZED
WITH 250 GALLONS OF MUD ACID & TESTED. ACIDIZED WITH 2000
GALLONS 15% REGULAR ACID.RECEIVED
STATE GEOLOGICAL COMMISSION

JUN 22 1976

CONSERVATION DIVISION
Wichita, KansasI HEREBY CERTIFY THE FOREGOING STATEMENTS ARE TRUE AND CORRECT TO THE BEST OF MY
KNOWLEDGE AND BELIEF.

REX & MORRIS DRILLING COMPANY


BY



A. H. FISHER

STATE OF KANSAS
COUNTY OF BUTLER, SS.

SUBSCRIBED AND SWORN TO BEFORE ME, A NOTARY PUBLIC, THIS 3RD DAY OF APRIL, 1970.

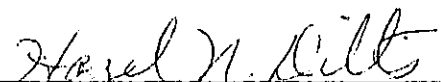
HAZEL N. DILTS, NOTARY PUBLIC

MY COMMISSION EXPIRES: MAY 5, 1973