


Give All Information Completely  
 Make Required Affidavit  
 Mail or Deliver Report to:  
 Conservation Division  
 State Corporation Commission  
 211 No. Broadway  
 Wichita, Kansas

Kingman County, Sec. 29 Twp. 29 Rge. 9 (E) (W)

NORTH

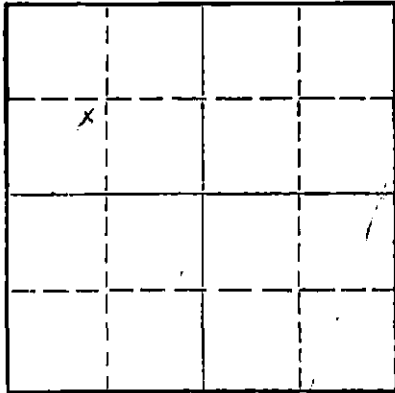

Locate well correctly on above  
 Section Plat

Location as "NE/CNWSW" or footage from lines NE-SW-NW  
 Lease Owner Bachus Oil Company  
 Lease Name Peggy Goetz Well No. 1  
 Office Address 721 E. Central, Wichita, Kansas  
 Character of Well (completed as Oil, Gas or Dry Hole) oil well  
 Date well completed 12-27-64 1964  
 Application for plugging filed 12-15-64 1964  
 Application for plugging approved 12-21-64 1964  
 Plugging commenced 12-23-64 1964  
 Plugging completed 12-23-64 1964  
 Reason for abandonment of well or producing formation depleted

If a producing well is abandoned, date of last production 19  
 Was permission obtained from the Conservation Division or its agents before plugging was commenced? yes

Name of Conservation Agent who supervised plugging of this well Archie Elving  
 Producing formation \_\_\_\_\_ Depth to top \_\_\_\_\_ Bottom \_\_\_\_\_ Total Depth of Well 2685 Feet  
 Show depth and thickness of all water, oil and gas formations.

**OIL, GAS OR WATER RECORDS**

**CASING RECORD**

FORMATION	CONTENT	FROM	TO	SIZE	PUT IN	PULLED OUT
				8 5/8	367	none
				5 1/2	990	none (circulated)
				2 1/2	2516	1925

Describe in detail the manner in which the well was plugged, indicating where the mud fluid was placed and the method or methods used in introducing it into the hole. If cement or other plugs were used, state the character of same and depth placed, from \_\_\_\_\_ feet to \_\_\_\_\_ feet for each plug set.

Pump 20 sacks of cement down 2 1/2" and stop plug at 2200'.  
 Set 15' rock bridge at 270' and fill to surface with 31 sacks of cement.

**RECEIVED**  
 STATE CORPORATION COMMISSION

DEC 29 1964

CONSERVATION DIVISION  
 Wichita, Kansas

(If additional description is necessary, use BACK of this sheet)

Name of Plugging Contractor Flint Engineering & Construction Company  
 Address Box 950, El Dorado, Kansas

STATE OF KANSAS, COUNTY OF BUTLER, ss.

\_\_\_\_\_, (employee of owner) or (owner or operator) of the above-described well, being first duly sworn on oath, says: That I have knowledge of the facts, statements, and matters herein contained and the log of the above-described well as filed and that the same are true and correct. So help me God.

(Signature) Steve Bawdle  
 El Dorado, Kansas

(Address)

SUBSCRIBED AND SWORN TO before me this 28th day of December, 1964

My commission expires 9-27-67

Ronald R. Harrison  
 Notary Public.