


WELL PLUGGING RECORD

Give All Information Completely
Make Required Affidavit
Mail or Deliver Report to:
Conservation Division
State Corporation Commission
212 North Market, Insurance Bldg.
Wichita, Kansas

NORTH

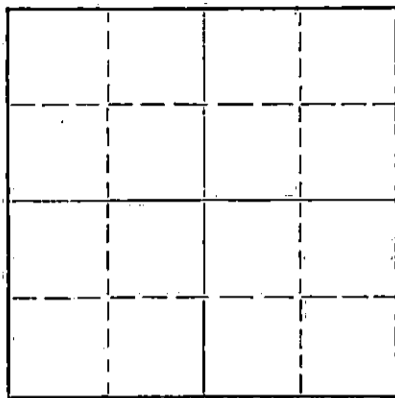

Locate well correctly on above
Section Flat

Kingman County, Sec. 29 Twp. 29 Rge. 9 (E) W. (W)
Location as "NE/CNW%SW%" or footage from lines 990' N. & 330' W. of Gen.
Lease Owner Cities Service Petroleum Company
Lease Name Reuter Well No. 2
Office Address Box 308, Great Bend, Kansas
Character of Well (completed as Oil, Gas or Dry Hole) Oil Well
Date well completed June 16 1957
Application for plugging filed May 4 1962
Application for plugging approved May 8 1962
Plugging commenced May 8 1962
Plugging completed May 12 1962
Reason for abandonment of well or producing formation Depleted and unprofitable.

If a producing well is abandoned, date of last production March 17 1962
Was permission obtained from the Conservation Division or its agents before plugging was commenced? Yes

Name of Conservation Agent who supervised plugging of this well Fred Hampel
Producing formation Viola Depth to top 4477' Bottom 4483' Total Depth of Well 4506 Feet
Show depth and thickness of all water, oil and gas formations.

OIL, GAS OR WATER RECORDS

CASING RECORD

FORMATION	CONTENT	FROM	TO	SIZE	PUT IN	PULLED OUT
				8-5/8"	368'	None
				5-1/2"	4506'	3442'

Describe in detail the manner in which the well was plugged, indicating where the mud fluid was placed and the method or methods used in introducing it into the hole. If cement or other plugs were used, state the character of same and depth placed, from _____ feet to _____ feet for each plug set.

4506-4420', filled hole with sand.
4420-4380', 5 sacks cement.
4380- 350', filled hole with mud.
350- 340', 10' rock bridge.
340- 280', 20 sacks cement.
280- 40', mud.
40- 30', rock bridge.
30' to base of cellar, cement.

RECEIVED
STATE CORP. COMMISSION
MAY 18 1962
CONSERVATION DIVISION

(If additional description is necessary, use BACK of this sheet)
Name of Plugging Contractor Southwest Casing Pulling Company
Address Great Bend, Kansas

STATE OF Kansas COUNTY OF Barton, ss.
John D. Forsyth (employee of owner) or (owner/operating) of the above-described well, being first duly sworn on oath, says: That I have knowledge of the facts, statements, and matters herein contained and the log of the above-described well as filed and that the same are true and correct. So help me God.

(Signature) John D. Forsyth
Box 308, Great Bend, Kansas
(Address)

SUBSCRIBED AND SWORN TO before me this 15th day of May, 1962

My commission expires March 12, 1963. W.D. Smith Notary Public.

INVOICED
DATE 5/18/62
INV. NO. 5009-W

WELL RECORD

WILDCAT.....

DISCOVERY.....

POOL.....

COMPANY Cities Service Oil Company WELL # 2 FARM Reuter

LOCATION 990' N. and 330' W. of Center, Section 29, Township 29, Range 9 W.

ELEV. 1676 (1674 Gr.) CO. Kingman STATE Kansas

IP. B.H.P.G. Potential 924 oil, no water, 2 1/2 hours, June 17, 1957.

PERFS.

FRAC. ACID None

T.D. 4506' P.B.T.D. 4492' GRAV/GOR.....

DRLG. COMM. December 29, 1956 COMP. January 16, 1957 CONTRACTOR Barbour Drlg. Co.

CASING RECORD:

6-5/8" at 368' with 250 sx. cem.
5-1/2" at 4506' with 150 sx. cem.

FORMATION RECORD:

clay and sand	0-175
red beds	400
red bed and shale	1150
shale and shells	1420
lime and shale	1585
shale and lime	1725
lime	1840
lime and shale	2095
shale and lime	2240
lime and shale	2605
shale and lime	2755
lime and shale	2915
broken lime	3030
lime and shale	3095
shale and lime	3220
lime	3390
shale and lime	3415
shale	3480
lime and shale	3605
lime	4009
lime and shale	4180
lime	4205
lime and shale	4227
lime	4252
lime and shale	4395
shale and lime	4439

FORMATION RECORD (continued):

cored shale (rec. 13')	4452
cored shale (rec. 1')	4454
cored shale (rec. 13')	4467
cored shale & lime (rec. 20')	4487
cored lime (rec. 9 1/2')	4497
lime	4507
4507 Rotary T.D. = 4506 S.L.M.	

Corr. Lansing	3596
Corr. Mississippi	4226
Corr. Kinderhook	4302
Vorr. Viola	4477
Pen.	29'
Corr. T.D.	4506

Drilled cement to 4492 S.L.M.

Perf. 20 shots 4477-83. Flowing in 2 hours 50 minutes.

SLOPE TESTS (Syfo):

358'	- 00
1000'	- 00
1500'	- 00
2000'	- 00

RECEIVED
STATE CORPORATION COMMISSION
MAY 7 1962
CONSERVATION DIVISION
Wichita, Kansas