


Give All Information Completely  
Make Required Affidavit  
Mail or Deliver Report to:  
Conservation Division  
State Corporation Commission  
211 No. Broadway  
Wichita, Kansas.

WELL PLUGGING RECORD

Kingman County, Sec. 29 Twp. 29S Rge. 9W (E) (W)

Location as "NE/CNWxSWx" or footage from lines SE-SW-NE  
Lease Owner Texaco Inc.  
Lease Name Edith Hiebsch Well No. 1  
Office Address 614 Bitting Bldg., Wichita, Kansas  
Character of Well (completed as Oil, Gas or Dry Hole) Oil  
Date well completed 11-15 19 56  
Application for plugging filed 3-26 19 63  
Application for plugging approved 4-27 19 63  
Plugging commenced 4-7 19 63  
Plugging completed 4-9 19 63  
Reason for abandonment of well or producing formation depleted

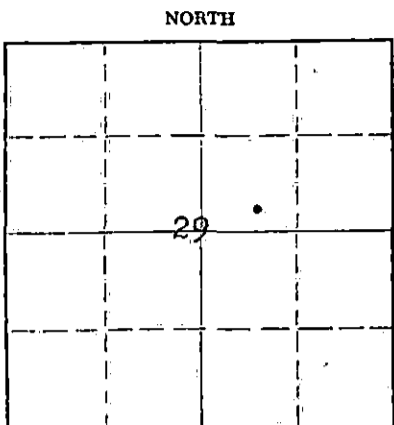

Locate well correctly on above Section Plat

If a producing well is abandoned, date of last production 3-31 19 63  
Was permission obtained from the Conservation Division or its agents before plugging was commenced? Yes

Name of Conservation Agent who supervised plugging of this well A. Elvin Pratt, Kansas  
Producing formation Viola Depth to top 4459 Bottom 4471 Total Depth of Well 4471 Feet  
Show depth and thickness of all water, oil and gas formations.

OIL, GAS OR WATER RECORDS

CASING RECORD

FORMATION	CONTENT	FROM	TO	SIZE	PUT IN	PULLED OUT
Viola	Oil & SW	4462	4471	10-3/4"	376	None
				7"	4462	2758

Describe in detail the manner in which the well was plugged, indicating where the mud fluid was placed and the method or methods used in introducing it into the hole. If cement or other plugs were used, state the character of same and depth placed, from \_\_\_\_\_ feet to \_\_\_\_\_ feet for each plug set.

Hole plugged as follows: Rock and 7 sacks cement 4471'-4443', heavy mud 4443'-210', rock bridge 210/-205', 25 sacks cement 205'-168', heavy mud 168'-35', 12 sacks cement 35 to surface

RECEIVED  
STATE CORPORATION COMMISSION

APR 18 1963

CONSERVATION DIVISION  
Wichita, Kansas

(If additional description is necessary, use BACK of this sheet)  
Name of Plugging Contractor Smith & Smith Casing Pulling  
Address Box 8, Cushing, Oklahoma

STATE OF Kansas, COUNTY OF Sedgwick, ss.  
H. N. Wade (employee of owner) or (owner or operator) of the above-described well, being first duly sworn on oath, says: That I have knowledge of the facts, statements, and matters herein contained and the log of the above-described well as filed and that the same are true and correct. So help me God.

(Signature) H. N. Wade

614 Bitting Bldg., Wichita, Kas.  
(Address)

SUBSCRIBED AND SWORN TO before me this 10th day of April, 1963

My commission expires June 30, 1964

[Signature]  
Notary Public.

15-095-00573-0000  
*file*

# LOG OF WELL

FORM PO-214 SHEET 1 (4-54)

**EDITH HIEBSCH NO. 1**

SHEET **1**

OWNER **The Texas Company** DIVISION **Oklahoma** DATE MADE **December 3, 1956**  
 DISTRICT **Kansas** LEASE **Edith Hiebisch** WELL NO. **1**  
 STATE **Kansas** COUNTY OR PARISH **Kingman** TWP. **29S** RANGE **9W** SEC. **29**  
 LOCATION OF WELL **SE SW NE**

COMMENCED RIGGING UP **10-6-56** COMMENCED DRILLING **10-6-56** COMPLETED DRILLING **11-2-56**  
 DAY DRILLER \_\_\_\_\_ NIGHT DRILLER \_\_\_\_\_ CONTRACTOR **Dutch Drlg. Co.**  
 CABLE FROM \_\_\_\_\_ TO \_\_\_\_\_ ROTARY FROM **0'** TO **4471'** COMPANY RIG NO. \_\_\_\_\_  
 TOTAL DEPTH **4471'** MEASURED BY **M. C. Harrell** ELEVATION **KB - 1673'**  
**DE - 1671'**  
**GL - 1663'**

## CASING RECORD

SIZE	WEIGHT	PUT IN WELL		PULLED OUT		LOST IN WELL		SHOES		PACKERS		SET AT
		FEET	INS.	FEET	INS.	FEET	INS.	LENGTH	MARK	KIND	LENGTH	
10-3/4"	32.75#	376'										FT.
7"	23#	237'										FT.
7"	20#	4246'										FT.
												FT.
												FT.
												FT.
												FT.
10-3/4" casing set at 354' with 185 sacks cement, 2% CC. Cement circulated.												FT.
7" casing set at 4462' with 200 sacks cement, 3% jel and 50% floccale.												FT.

WAS CASING CEMENTED? \_\_\_\_\_ IF SO, HOW MANY SACKS OF CEMENT USED? \_\_\_\_\_  
 LINER: STATE SIZE AND WEIGHT \_\_\_\_\_ WHERE SET \_\_\_\_\_ FT. AND INS. BLANK \_\_\_\_\_ FT. AND INS. PERFORATED \_\_\_\_\_  
 HOW PUT TOGETHER \_\_\_\_\_ COUPLING \_\_\_\_\_ FLUSH-JOINT \_\_\_\_\_ INSERTED \_\_\_\_\_  
 REMARKS: \_\_\_\_\_

## EQUIPMENT RECORD

TUBING				SUCKER RODS			PUMPING OUTFIT	
SIZE	WEIGHT	FEET	INS.	FEET	INS.	SIZE AND KIND, ( )	DESCRIPTION, KIND, SIZE, ETC.	

Completed Testing 11-15-56  
 FLOWING, PUMPING, GASSEY OR DRY **Flowing** PRODUCTION FIRST 24 HOURS **108 BO, NW in 8 hrs.** PRODUCTION SETTLED \_\_\_\_\_  
 IF GAS WELL, OPEN FLOW CAPACITY \_\_\_\_\_ SHUT IN PRESSURE \_\_\_\_\_ ROCK PRESSURE \_\_\_\_\_  
 KIND OF SHOT \_\_\_\_\_ SIZE OF SHOT, QUARTS \_\_\_\_\_  
 NUMBER OF SHELLS \_\_\_\_\_ SIZE OF SHELLS \_\_\_\_\_ INCHES, DIAMETER \_\_\_\_\_  
 LENGTH OF SHELLS \_\_\_\_\_ FEET \_\_\_\_\_ INCHES \_\_\_\_\_ TOP OF SHOT \_\_\_\_\_  
 BOTTOM OF SHOT \_\_\_\_\_ ANCHOR \_\_\_\_\_ WELL BRIDGED TO \_\_\_\_\_  
 TOTAL DEPTH OF WELL \_\_\_\_\_ NUMBER OF SHOT \_\_\_\_\_ PRODUCTION BEFORE SHOT \_\_\_\_\_ BBLs. PER DAY \_\_\_\_\_  
 PRODUCTION AFTER SHOT \_\_\_\_\_ BBLs. PER DAY. SHOT FURNISHED BY \_\_\_\_\_  
 NAME OF SHOOTER \_\_\_\_\_ SHOT INSPECTED \_\_\_\_\_ BY \_\_\_\_\_ (COMPANY EMPLOYEE)  
 COMMENCED DRILLING DEEPER \_\_\_\_\_ COMPLETED \_\_\_\_\_ DRILLING DEEPER \_\_\_\_\_  
 TOTAL DEPTH \_\_\_\_\_ PRODUCTION FIRST 24 HOURS \_\_\_\_\_ PRODUCTION SETTLED \_\_\_\_\_  
 REMARKS: **Edith Hiebisch #1**  
**Goetz Pool**  
**TD 4471'**  
**Completed Drilling 11-2-56**  
**Completed Testing 11-15-56**

NOTE: IF WELL WAS DRY, STATE UNDER REMARKS, WHEN, HOW, AND BY WHOM PLUGGED.  
 STATE UNDER REMARKS ANYTHING OF INTEREST NOT COVERED IN LOG.  
 IF THE SPACE PROVIDED FOR REMARKS IS NOT SUFFICIENT WRITE ON BOTTOM OF LAST SHEET OF LOG.

\$3.75, \$480.00, \$400.00, \$300.00 (wait)


TOTAL NUMBER OF SHEETS \_\_\_\_\_

Well Log  
 #1 Edith Hiebsch  
 SE SW NE Sec 29-29S-9W  
 Kingman County, Kansas

0	-	70	Sand	
70	-	357	Shale and shells	
357	-	680	Red rock and shells	
680	-	1320	Shale and shells	
1320	-	1415	Lime and shale	
1415	-	2090	Lime	
2090	-	2265	Shale	
2265	-	2380	Lime and shale breaks	
2380	-	2510	Lime and shale	
2510	-	2685	Shale	
2685	-	2750	Lime	
2750	-	2857	Lime and shale	
2857	-	2970	Lime and shale breaks	
2970	-	3150	Lime and shale	
3150	-	3247	Lime	
3247	-	3405	Lime and shale	<u>Top of Formation</u>
3405	-	3449	Lime	
3449	-	3485	Douglas shale	Mississippi Chat 4229
3485	-	3590	Lime and shale	Viola Lime 4459
3590	-	3675	Lime	
3675	-	3730	K. C. Lime	
3730	-	3850	Lime	
3850	-	3880	Dense lime	
3880	-	4079	Lime	
4079	-	4120	Shale and lime streaks	
4120	-	4165	Lime and shale	
4165	-	4202	Lime and shale breaks	
4202	-	4255	Miss. lime	
4255	-	4291	Cherty lime	
4291	-	4316	Shale	
4316	-	4365	Lime and shale	
4365	-	4418	Kinderhook shale	
4418	-	4457	Shale	
4457	-	4470	Viola lime	
4470	-		TD	

State of Kansas SS  
 County of Barton

T. D. Sweetman, president of Dutch Drilling Co., Inc., being first duly sworn on oath says: That I have knowledge of the facts, statements and matters herein contained and the log of the above described well as filed and that the same are true and correct.

  
 T. D. Sweetman

Subscribed and sworn before me this 7th. day of November, 1956.

  
 Dick B. Evans  
 Notary Public Barton County

My Commission expires May 9, 1959