

15-095-00566-0000

STATE OF KANSAS
STATE CORPORATION COMMISSION

Form CP-4


WELL PLUGGING RECORD

Give All Information Completely
Make Required Affidavit
Mail or Deliver Report to:
Conservation Division
State Corporation Commission
211 No. Broadway
Wichita, Kansas

KINGMAN County. Sec. 29 Twp. 29 Rge. 9W (E) (W)

Location as "NE/CNW/SW" or footage from lines NW NE SW
Lease Owner SANTA FE PIPE & SUPPLY
Lease Name GOETZ Well No. 3
Office Address P. O. BOX 562 - GREAT BEND, KANSAS
Character of Well (completed as Oil, Gas or Dry Hole) GAS
Date well completed OCTOBER 28 19 56
Application for plugging filed JANUARY 7 19 64
Application for plugging approved JANUARY 8 19 64
Plugging commenced JANUARY 8 19 64
Plugging completed JANUARY 17 19 64
Reason for abandonment of well or producing formation DEPLETED

NORTH

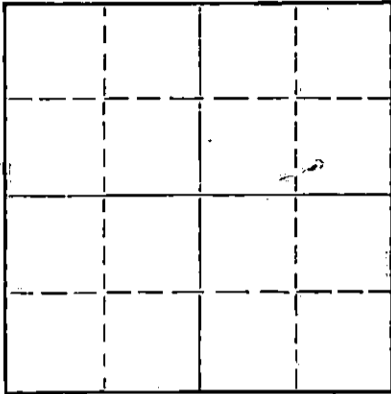

Locate well correctly on above
Section Plat

If a producing well is abandoned, date of last production 19
Was permission obtained from the Conservation Division or its agents before plugging was commenced?

Name of Conservation Agent who supervised plugging of this well
Producing formation Depth to top Bottom Total Depth of Well 4483' Feet
Show depth and thickness of all water, oil and gas formations.

OIL, GAS OR WATER RECORDS

CASING RECORD

FORMATION	CONTENT	FROM	TO	SIZE	PUT IN	PULLED OUT
				8 5/8"	199.59'	NONE
				5 1/2"	4482'	3765'

Describe in detail the manner in which the well was plugged, indicating where the mud fluid was placed and the method or methods used in introducing it into the hole. If cement or other plugs were used, state the character of same and depth placed, from feet to feet for each plug set.

PLUGGED BACK WITH SAND FROM 4434' TO 4400'. MIXED AND DUMPED 5 SACKS CEMENT FROM 4400' TO 4360'. PULLED CASING. MUDDERED HOLE TO 270'. SET 10' ROCK BRIDGE FROM 270' TO 260'. MIXED AND DUMPED 35 SACKS CEMENT FROM 260' TO 155'. MUDDERED HOLE FROM 155' TO 40'. SET 10' ROCK BRIDGE FROM 40' TO 30'. MIXED AND DUMPED 10 SACKS OF CEMENT FROM 30' TO BASE OF THE CELLAR.

RECEIVED
STATE CORPORATION COMMISSION

3-20-64 MAR 20 1964

CONSERVATION DIVISION
Wichita, Kansas

(If additional description is necessary, use BACK of this sheet)

Name of Plugging Contractor ACE PIPE PULLING COMPANY
Address P. O. BOX 304 - GREAT BEND, KANSAS

STATE OF KANSAS, COUNTY OF BARTON, ss.
T. L. NUTT (employee of owner) or (owner or operator)

well, being first duly sworn on oath, says: That I have knowledge of the facts, statements, and matters herein contained and the log of the above-described well as filed and that the same are true and correct. So help me God.

(Signature)

P. O. BOX 562 - GREAT BEND, KANSAS
(Address)

SUBSCRIBED AND SWORN to before me this 19TH day of MARCH, 19 64

Mary M. Guesnier
Mary M. Guesnier Notary Public.

My commission expires JULY 31, 1966

15-095-00566-0000


WELL LOG BUREAU—KANSAS GEOLOGICAL SOCIETY
508 East Murdock, Wichita, Kansas

Company- PRYOR & TRACY & D & M DRILLING CO.
Farm- Goatz No. 3

SEC. 29 T. 29 R. 9W
NW NE SW

Total Depth. 4483
Comm. 10-14-56 Comp. 10-28-56
Shot or Treated.
Contractor.
Issued. 12-29-56

County Kingman
KANSAS

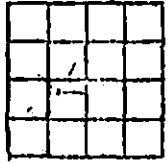

CASINO:

8 5/8" 199.59' cem w/175 sx.
5 1/2" 4482' cem w/100 sx.

Elevation. 1671 RB

Production. 20,000,000 gas

Figures indicate Bottom of Formations.

sand, red bed	199
redbed, sand, shale	1160
lime, shale, shells	1547
lime, shale	1675'
lime, shale, chert	1835
lime, shale	3662
lime	3764
lime, shale	3802
lime	3987
lime, shale	4108
lime	4139
lime, shale	4399
lime, shale, chert	4425
lime, shale	4466
shale Simpson	4474
sand	4482
sand	4483
Total Depth	

Tops: Scout	
Heebner	3382
Douglas	3460
Brown lime	3584
Lansing	3592
Base Kansas City	4014
Miss. Zone	4178
Miss. lime	4218
Kinderhook	4227
Viola	4402
Simpson	4474

RECEIVED
STATE CORPORATION COMMISSION

MAR 20 1964

CONSERVATION DIVISION
Wichita, Kansas

RECEIVED

DEC 19 1963

Santa Fe Pipe & Supply