


STATE OF KANSAS
STATE CORPORATION COMMISSION

Give All Information Completely
Make Required Affidavit
Mail or Deliver Report to:
Conservation Division
State Corporation Commission
212 North Market, Insurance Bldg.
Wichita, Kansas

WELL PLUGGING RECORD

Kingman County. Sec. 31 Twp. 29 Rge. 9W (E) (W)
Location as "NE/CNW%SW%" or footage from lines NW SW NE
Lease Owner D & M Drilling Co.
Lease Name Carter Estate Well No. # 1
Office Address Box 247 Great Bend, Kansas
Character of Well (completed as Oil, Gas or Dry Hole) _____
Date well completed _____ 19____
Application for plugging filed yes 19____
Application for plugging approved yes 19____
Plugging commenced 11-16-59 19____
Plugging completed 11-25-59 19____
Reason for abandonment of well or producing formation _____

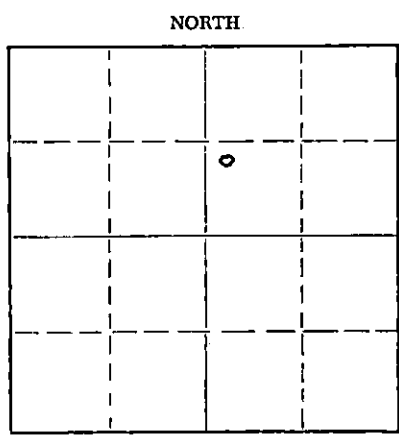

Locate well correctly on above Section Plat

If a producing well is abandoned, date of last production _____ 19____
Was permission obtained from the Conservation Division or its agents before plugging was commenced? yes

Name of Conservation Agent who supervised plugging of this well Fred W. Hampel
Producing formation _____ Depth to top _____ Bottom _____ Total Depth of Well 4363' Feet
Show depth and thickness of all water, oil and gas formations.

OIL, GAS OR WATER RECORDS					CASING RECORD	
FORMATION	CONTENT	FROM	TO	SIZE	PUT IN	PULLED OUT
				5 1/2"		1313.'

Describe in detail the manner in which the well was plugged, indicating where the mud fluid was placed and the method or methods used in introducing it into the hole. If cement or other plugs were used, state the character of same and depth placed, from _____ feet to _____ feet for each plug set.

Measured into total depth.
Plugging started 11-16-59 Plugging finished 11-25-59.
Plugged off bottom by sanding back to 4400' and dumping 5 sacks of cement. Worked and shot pipe. Shot 5 1/2" casing at 1313'. Circulated and spotted 85 barrels of oil. Pulled and laid down casing. Filled hole with mud to 300' and set rock bridge. Dumped 15 sacks of cement. Mudded to 190'. Set rock bridge and dumped 10 sacks of cement. Mudded to 40'. Set rock bridge and capped the well with 10 sacks of cement.

RECEIVED
STATE CORPORATION COMMISSION
DEC 16 1959
CONSERVATION DIVISION
Wichita, Kansas

(If additional description is necessary, use BACK of this sheet)
Name of Plugging Contractor J. O. Forbes
Address Box 221, Great Bend, Kansas

STATE OF Kansas, COUNTY OF Barton, ss.
J. O. Forbes (employee of owner) or (owner or operator) of the above-described well, being first duly sworn on oath, says: That I have knowledge of the facts, statements, and matters herein contained and the log of the above-described well as filed and that the same are true and correct. So help me God.

(Signature) J. O. Forbes
Box 221, Great Bend, Kansas (Address)

SUBSCRIBED AND SWORN TO before me this 30 day of Nov, 1959

My commission expires April 8, 1961

Arthur F. Schubert
Notary Public.