

15-095-00166-0000


STATE OF KANSAS  
STATE CORPORATION COMMISSION

Give All Information Completely  
Make Required Affidavit  
Mail or Deliver Report to:  
Conservation Division  
State Corporation Commission  
800 Bitting Building  
Wichita, Kansas

WELL PLUGGING RECORD

Kingman County, Sec. 31 Twp. 29S Rge. 9 ~~XX~~ W (W)  
Location as "NE/CNW/SW" or footage from lines NW/4 SW/4 NE/4

Lease Owner Bryor & Tracy  
Lease Name Carter Estate Well No. 1  
Office Address 811 Union National Bank Bldg., Wichita 2, Kansas  
Character of Well (completed as Oil, Gas or Dry Hole) Dry Hole  
Date well completed 1/7 19 56  
Application for plugging filed 1/7 19 56  
Application for plugging approved 1/7 19 56  
Plugging commenced 1/7 19 56  
Plugging completed 1/7 19 56  
Reason for abandonment of well or producing formation Dry Hole

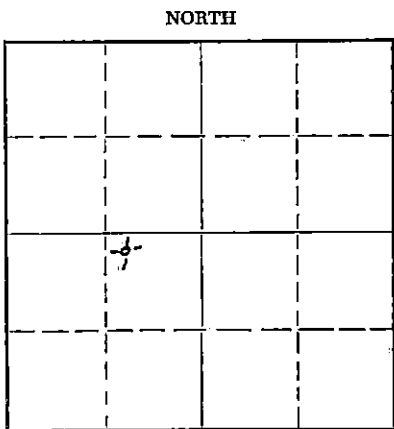

Locate well correctly on above  
Section Flat

If a producing well is abandoned, date of last production \_\_\_\_\_ 19\_\_\_\_  
Was permission obtained from the Conservation Division or its agents before plugging was commenced? Yes

Name of Conservation Agent who supervised plugging of this well M. A. Rives, Pratt, Kansas  
Producing formation \_\_\_\_\_ Depth to top \_\_\_\_\_ Bottom \_\_\_\_\_ Total Depth of Well 4600 Feet  
Show depth and thickness of all water, oil and gas formations.

OIL, GAS OR WATER RECORDS

CASING RECORD

FORMATION	CONTENT	FROM	TO	SIZE	PUT IN	PULLED OUT
TD drilled to Arbuckle				8 5/8		

Describe in detail the manner in which the well was plugged, indicating where the mud fluid was placed and the method or methods used in introducing it into the hole. If cement or other plugs were used, state the character of same and depth placed, from \_\_\_\_\_ feet to \_\_\_\_\_ feet for each plug set.

Filled with heavy mud to 195', 1/2 sack hulls, 20 sacks cement; pushed plug to 35' and 1/2 sack hulls and 10 sacks cement.

RECEIVED  
STATE CORPORATION COMMISSION

JAN 14 1956 1-14-56

CONSERVATION DIVISION  
WICHITA, KANSAS

(If additional description is necessary, use BACK of this sheet)  
Name of Plugging Contractor D & M Drilling Company, Inc.  
Address P. O. Box 247, Great Bend, Kansas

STATE OF Kansas, COUNTY OF Barton, ss.  
Don S. Packer (employee of owner) or (owner or operator) of the above-described well, being first duly sworn on oath, says: That I have knowledge of the facts, statements, and matters herein contained and the log of the above-described well as filed and that the same are true and correct. So help me God.

(Signature) [Signature]  
Box 247, Great Bend, Kansas  
(Address)

SUBSCRIBED AND SWORN TO before me this 10th day of January, 19 56

My commission expires July 29, 1957

[Signature] Notary Public.

PLUGGING  
FILE SEC. 31 T. 29 R. 9W  
BOOK PAGE 30 LINE 26

CARTER ESTATE #1

NW/4 SW/4 NE/4 of Section 31-29S-9W Kingman County, Kansas

Rigged up Rotary Tools 12/19/55

Ran 10 Jts. (200') 8-5/8" Surface  
Pipe set @ 200'. Cemented with  
200 sacks common cement, 2% CC

Tore down Rotary Tools 1/7/56

<u>FORMATION</u>	<u>FROM</u>	<u>TO</u>
Surface sand	0'	200'
Redbed & shells	200	1000
Shale & shells	1000	1190
Salt	1190	1260
Shale & shells	1260	1440
Lime & shale	1440	3170
Shale & chalky lime	3170	3200
Lime & shale	3200	3590
Lime	3590	3987
Lime & shale	3987	4185
Lime & chert	4185	4200
Cherty lime	4200	4210
Lime & shale	4210	4260
Shale	4260	4395
Shale & lime	4395	4430
Lime	4430	4445
Shale, lime & sand	4445	4480
Sand	4480	4486
Shale	4486	4513
Sand & shale	4513	4522
Shale	4522	4600 TD

I, W. M. Barnett, do hereby certify that the foregoing log is true and correct, to the best of my knowledge and belief.

W. M. Barnett

Subscribed and sworn to before me this 10th day of January, 1956

James Sweeney  
Notary Public

My commission expires: July 29, 1957

RECEIVED  
STATE COMMISSION  
DIVISION  
JAN 11 1956

**PLUGGING**  
FILE SEC 31-29S-9W  
PAGE 30 LINE 26