

TO: STATE CORPORATION COMMISSION
CONSERVATION DIVISION - PLUGGING
130 SOUTH MARKET, SUITE 2078
WICHITA, KANSAS 67202

API Well Number: 15-129-20934-00-00
Spot: E2SENE Sec/Twnshp/Rge: 6-34S-42W
3300 feet from S Section Line, 590 feet from E Section Line
Lease/Unit Name: AUSTIN B Well Number: 1
County: MORTON Total Vertical Depth: 4775 feet

Operator License No.: 5447
Op Name: OXY USA, INC.
Address: PO BOX 27570 5 E GREENWAY PLZ ST
HOUSTON, TX 77227

Production Casing Size: 5.5 feet: 4774 WITH 1245 SX CMT
Surface Casing Size: 8.625 feet: 1264 WITH 475 SX CMT

155¹⁹

Well Type: OIL UIC Docket No: _____ Date/Time to Plug: 06/03/2003 2:10 PM
Plug Co. License No.: 31151 Plug Co. Name: SARGENT AND HORTON PLUGGING, INC.
Proposal Rcvd. from: DON HORTON Company: SARGENT AND HORTON PLUGGI Phone: (580) 854-6515

Proposed Plugging Method: CIBP @ 3350' WITH 2 SX CMT. PLUG AT 800' WITH 40 SX CMT. PLUG AT 350' WITH 40 SX CMT. PLUG AT 40' WITH 10 SX CMT.

Plugging Proposal Received By: KEVIN STRUBE WitnessType: Plugging Operations 100% Witnessed (Complete)
Date/Time Plugging Completed: 06/03/2003 5:00 PM KCC Agent: KEVIN STRUBE

Actual Plugging Report:


PBTD 3330'. PERFS AT 3506-16'. CIBP @ 3500'. PERFS AT 3370-83'. CIBP @ 3350'. CIBP @ 3350' WITH 2 SX CMT. DV @ 3152' WITH 735 SX CMT. PULLED ON CASING HAD NO STRETCH, MAYBE 200' OF FREE PIPE. TAGGED FLUID LEVEL AT 1834'. PUMP 13 BBL MUD. SPACED TO 1300'. PUMPED 25 SX CMT & 10 BBL MUD. TAGGED FL @ 590'. PUMPED 2 BBL MUD & 57 SX CMT. PRESSURED UP TO 500#. PUMPED DOWN 8 5/8" X 5 1/2" 15 SX CMT. PRESSURED UP TO 500#.

RECEIVED
JUN 06 2003
KCC WICHITA

Remarks: USED COMMON CEMENT BY SARGENTS. NO CASING RECOVERED.

Plugged through: CSG

District: 01

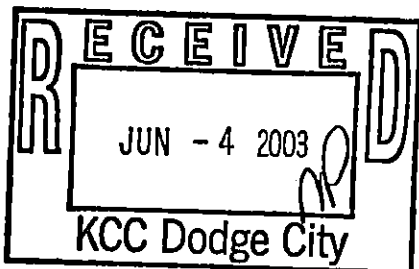

Signed

Kevin D. Strube

(TECHNICIAN)

INVOICED
DATE 6-9-03
2003061625

Form CD-203