


STATE OF KANSAS  
STATE CORPORATION COMMISSION  
Give All Information Completely  
Make Required Affidavit  
Mail or Deliver Report to:  
Conservation Division  
State Corporation Commission  
212 No. Market  
Wichita, Kansas

WELL PLUGGING RECORD

NORTH

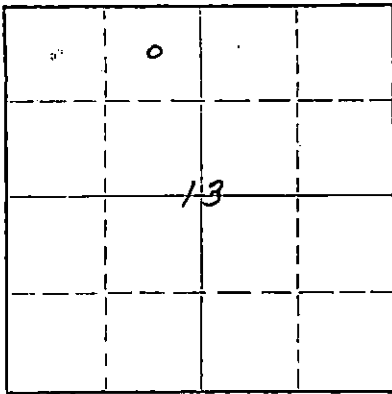

Locate well correctly on above Section Plat

Sumner County, Sec. 13 Twp. 34S Rge. (E) 4 (W)  
Location as "NE/CNWxSWx" or footage from lines NE NW  
Lease Owner Appleton Oil Company  
Lease Name Conrady Well No. 1  
Office Address 506 Beacon Building Tulsa, Okla.  
Character of Well (completed as Oil, Gas or Dry Hole) Dry Hole  
Date well completed 8-27 1967  
Application for plugging filed 8-27 1967  
Application for plugging approved 8-27 1967  
Plugging commenced 8-27 1967  
Plugging completed 8-27 1967  
Reason for abandonment of well or producing formation no commercial oil shows  
If a producing well is abandoned, date of last production -- 19  
Was permission obtained from the Conservation Division or its agents before plugging was commenced? Yes

Name of Conservation Agent who supervised plugging of this well Howard Hess  
Producing formation none Depth to top -- Bottom -- Total Depth of Well 4818 Feet  
Show depth and thickness of all water, oil and gas formations.

OIL, GAS OR WATER RECORDS

CASING RECORD

FORMATION	CONTENT	FROM	TO	SIZE	PUT IN	PULLED OUT
Stalneker	water	3292	3358	8-5/8"	250.91'	none
Miss.	"	4324	4338			
Misener	"	4761	4764			

Describe in detail the manner in which the well was plugged, indicating where the mud fluid was placed and the method or methods used in introducing it into the hole. If cement or other plugs were used, state the character of same and depth placed, from -- feet to -- feet for each plug set.

The well was plugged as follows:  
Hole filled w/mud to surface casing  
1/2 sack hulls set at base of surface 260' from KB  
Pumped 20 sacks cement through drill pipe on top of plug hole filled with mud to 40'  
Set 1/2 sack of hulls at 40'  
Pumped 8 sacks cement through drill pipe from 40' to surface.  
2 sack plug in rat-hole.

(If additional description is necessary, use BACK of this sheet)

Name of Plugging Contractor Curt Brown Drilling Co.  
Address Mayo Building, Tulsa, Oklahoma

STATE OF OKLAHOMA, COUNTY OF TULSA, ss.  
DAVID A. BRIERLEY (employee of owner) or (owner) of the above-described well, being first duly sworn on oath, says: That I have knowledge of the facts, statements, and matters herein contained and the log of the above-described well as filed and that the same are true and correct. So help me God.

(Signature) David A. Brierley

SUBSCRIBED AND SWORN TO before me this 6th day of September, 1967

My Commission Expires April 27, 1971  
Yetta Britch Notary Public.

APPLETON OIL COMPANY  
CONRADY #1 WELL LOG  
NE NW Sec. 13-T34S-R4W  
Sumner County, Kansas  
Elev. 1169' K.B.

0- 250	Shale
250-680	Shale & Sand
680- 876	Anhydride & Salt
876-1615	Shale & Lime
1615-1740	Lime
1740-2090	Shale, Lime & Sand
2090-2380	Lime & Shale
2380-2516	Shale
2516-2645	Lime
2645-2820	Shale & Lime
2820-3020	Lime & Shale
3020-3212	Shale
3212-3292	Shaley Sand
3292-3358	Sand
3358-3595	Shale
3595-3846	Lime
3846-3926	Shale & Lime
3926-4071	Lime
4071-4285	Shale & Lime
4285-4320	Chert, Lime & Shale S.O.
4320-4324	Lime
4324-4338	Chert & Weathered Chert & Lime
4338-4695	Lime & Chert
4695-4748	Shale
4748-4761	Black Shale
4761-4763	Sand S.S.O.
4763-4785	Lime
4785-4797	Sandy Shale
4797-4801	Sand
4801-4818	Sandy Shale
T.D.	

RECEIVED  
CORPORATION COMMISSION

SEP 8 1967

CONSERVATION DIVISION  
Wichita, Kansas

LOG TOPS:

Topeka	2516	Reworked Mississippi	4285
Heebner	2883	Mississippi	4320
Stalneker Zone	3212	Kinderhook	4695
B/Stalneker	3358	Chattanooga	4747
Kansas City	3595	Misener	4761
B/Kansas City	3846	Viola	4764
Cherokee	4071	Simpson	4785

This is a true and accurate copy of Drillers Log.

Curt Brown  
Curt Brown  
Curt Brown Drilling Company  
Tulsa; Oklahoma