

STATE OF KANSAS
STATE CORPORATION COMMISSION

WELL PLUGGING RECORD


Give All Information Completely
Make Required Affidavit
Mail or Deliver Report to:
Conservation Division
State Corporation Commission
800 Biting Building
Wichita, Kansas

Sumner

County, Sec. 12 Twp. 34S Rge. (E) 4 (W)

Location as "NE/CNW%SW%" or footage from lines SW NW NW
Lease Owner Herndon Drilling Company
Lease Name Charlie Sears Well No. 1
Office Address Drawer 489, Tulsa, Oklahoma
Character of Well (completed as Oil, Gas or Dry Hole) Dry Hole
Date well completed 2-1-59 19
Application for plugging filed 2-1-59 19
Application for plugging approved 2-1-59 19
Plugging commenced 2-2-59 19
Plugging completed 2-2-59 19
Reason for abandonment of well or producing formation Dry Hole

NORTH

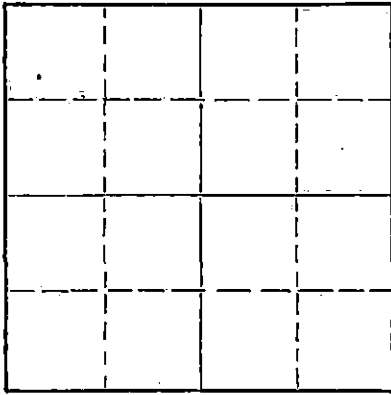

Locate well correctly on above Section Plat

If a producing well is abandoned, date of last production _____ 19
Was permission obtained from the Conservation Division or its agents before plugging was commenced? _____

Name of Conservation Agent who supervised plugging of this well Gene Grahm
Producing formation _____ Depth to top _____ Bottom _____ Total Depth of Well 4741 Feet
Show depth and thickness of all water, oil and gas formations.

OIL, GAS OR WATER RECORDS

CASING RECORD

FORMATION	CONTENT	FROM	TO	SIZE	PUT IN	PULLED OUT
				8-5/8	305	None

Describe in detail the manner in which the well was plugged, indicating where the mud fluid was placed and the method or methods used in introducing it into the hole. If cement or other plugs were used, state the character of same and depth placed, from _____ feet to _____ feet for each plug set.

Filled hole with mud to 240 ft. Bridged hole @ 240 ft. Pumped 30 sx. cement thru drill pipe by Halliburton on bridge. Filled hole with mud to 40 ft. Placed plug @ 40 ft. and filled hole with cement by Halliburton to surface.

RECEIVED
STATE CORPORATION COMMISSION
MAR 25 1959
CONSERVATION DIVISION
Wichita, Kansas

(If additional description is necessary, use BACK of this sheet)

Name of Plugging Contractor Herndon Drilling Company
Address Drawer 489, Tulsa, Oklahoma

STATE OF Oklahoma, COUNTY OF Tulsa, ss.
W. G. Prather (employee of owner) or (owner or operator) of the above-described

well, being first duly sworn on oath, says: That I have knowledge of the facts, statements, and matters herein contained and the log of the above-described well as filed and that the same are true and correct. So help me God.

(Signature)

W. G. Prather
Box 436, Lyons, Kansas
(Address)

SUBSCRIBED AND SWORN to before me this 18th day of March, 1959

My commission expires June 19, 1961

Johanna Alene Jones
Notary Public.

PLUGGING
FILE SEC. 12 T. 34 R. 4W
BOOK PAGE 24 LINE 25

WELL LOG

6


Spudding date 1-21-59
 Date entry completed 1-21-59
 Date log completed 1-21-59

FROM	TO	DESCRIPTION	REMARKS

RECEIVED
 STATE CORPORATION COMMISSION
 MAR 25 1959
 CONSERVATION DIVISION
 Wichita, Kansas

Subscribed and sworn to before me this _____ day of _____ 1959.

I certify and above and foregoing to be true and correct copy of the original entry log on this _____ day of _____ 1959.

WITNESSES: _____

My commission expires _____

By _____

147-210 (P) 210-11

PLUGGING
 FILE SEC 12 T. 34 R. 9 W.
 BOOK PAGE 24 LINE 25