

STATE OF KANSAS  
STATE CORPORATION COMMISSION  
200 Colorado Derby Bldg.  
Wichita, Kansas 67202

Form CP-4  
Rev. 12-15-80

WELL PLUGGING RECORD

Give All Information Completely  
Make Required Affidavit

COUNTY Barber SEC. 35 TWP. 34S RGE. 15W E/W  
Location as in quarters or footage from lines:  
C of SW NE


Locate Well  
correctly on above  
Section Platt.

Lease Owner Westmore Drilling Company, Inc.  
Lease Name Davis Ranch Well No. E-1  
Office Address Chapin Bldg. Medicine Lodge, Ks. 67104  
Character of Well (Completed as Oil, Gas or Dry Hole): \_\_\_\_\_  
Date Well Completed \_\_\_\_\_  
Application for plugging filed \_\_\_\_\_  
Plugging commenced 10-5-81  
Plugging completed 10-9-81  
Reason for abandonment of well or producing formation \_\_\_\_\_

\_\_\_\_\_ Depleted  
Was permission obtained from the Conservation Division or it's  
Agent's before plugging was commenced? yes

Name of Conservation Agent who supervised plugging of this well Maurice Leslie  
Producing formation \_\_\_\_\_ Depth to top \_\_\_\_\_ bottom T.D. 4925'

Show depth and thickness of all water, oil and gas formations.

OIL, GAS OR WATER RECORDS

Casing Record

Formation	Content	From	To	Size	Put in	Pulled Out
				8-5/8"	870'	none
				4-1/2"	4924'	3201'

Describe in detail the manner in which the well was plugged, indicating where the mud fluid was placed and the method or methods used in introducing it into the hold. If cement or other plugs were used, state the character of same and depth placed, from \_\_\_\_\_ feet to \_\_\_\_\_ feet for each plug set.

~~Moved in on location, plugged off bottom with sand to 4800' and set 4 sacks cement.~~  
~~Pulled 28" tension, shot and worked pipe @ 4105', 3940', 3805', 3620', 3395' and 3200'.~~  
~~Pulled 88 joints of pipe. Plugged well with 5 sacks hulls, 12 sacks gel, 50 sacks cement,~~  
~~7 sacks gel, 8-5/8" plug, 50 sacks cement, 6 sacks gel and 25 sacks cement. Plugging~~  
~~Completed.~~

(If additional description is necessary, use BACK of this sheet)


Name of Plugging Contractor Kelso Casing Pulling

STATE OF Kansas COUNTY OF Rice, ss.  
R. Darrell Kelso (employee of owner) or (owner or operator) of the  
above-described well, being first duly sworn on oath, says: That I have knowledge of the  
facts, statements, and matters herein contained and the log of the above-described well as  
filed and that the same are true and correct. So help me God.

(Signature) R. Darrell Kelso  
Chase, Kansas  
(Address)

SUBSCRIBED AND SWORN TO before me this 12th day of October, 19 81

My Commission expires:

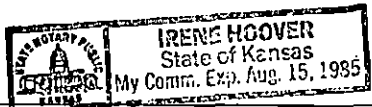

Irene Hoover  
Notary Public  
STATE CORPORATION COMMISSION

OCT 15 1981  
10-15-1981  
CONSERVATION DIVISION  
Wichita, Kansas

**DRILLER'S WELL LOG**

OPERATOR: K & E DRILLING, INC.  
719 Union Center Building  
Wichita, Kansas

WELL NAME: #1 Davis Ranch "E"  
LOCATION: App. C SW NE, 35-34S-15W  
Barber County, Kansas

CONTRACTOR: **K & E DRILLING, INC.**  
719 UNION CENTER BLDG.  
WICHITA, KANSAS

COMMENCED: July 1, 1964

CASING RECORD: 8-5/8" @ 870' w/500 sx.  
4-1/2" @ 4924' w/125 sx.

COMPLETED: July 13, 1964

ELEVATION: 1570' K.B.

ROTARY TOTAL DEPTH: 4925'

PRODUCTION: Mississippian Gas

**FORMATION RECORD**

*Depths shown indicate bottom of formations encountered.*

Soil & Rock	40
Shale & Red Bed	640
Shale & Shells	870
Red Bed	1150
Shale & Shells	1800
Lime & Shale	1920
Lime	2595
Lime & Shale	2920
Lime	3064
Shale & Lime	3260
Lime	3465
Lime & Shale	3810
Lime	3993
Lime & Shale	4280
Lime	4925 T.D.

**CERTIFICATION**

State of KANSAS }  
County of SEDGWICK } ss:

I, Wayne L. Brinegar, of K&E DRILLING, INC., upon oath state that the above and foregoing is a true and correct copy of the Driller's Log of the above named well.

Wayne L. Brinegar  
Wayne L. Brinegar

Subscribed and sworn to before me this 15th day of July, 19 64.

My Commission expires: August 30, 1965

Jolene M. Bannon  
Jolene M. Bannon Notary Public.

RECEIVED  
STATE CORPORATION COMMISSION

JUN -5 1981

CONSERVATION DIVISION  
Wichita, Kansas

K & E DRILLING, INC.



Rotary Drilling Contractors