


STATE OF KANSAS
CORPORATION COMMISSION
Give All Information Completely
Make Required Affidavit
Mail or Deliver Report to:
Conservation Division
State Corporation Commission
211 No. Broadway
Wichita, Kansas

WELL PLUGGING RECORD

Barber County, Sec. 12 Twp. 34S Rge. (X) 15(W)

Location as "NE/CNW/SW" or footage from lines 5' North of W $\frac{1}{2}$ - SW - NE
Lease Owner Champlin Oil & Refining Co.
Lease Name Davis Ranch "J" Well No. 2
Office Address Box 308, Ellinwood, Kansas
Character of Well (completed as Oil, Gas or Dry Hole) Dry Hole
Date well completed September 16 1962
Application for plugging filed September 19 1962
Application for plugging approved September 16 (Verbal) 1962
Plugging commenced September 16 1962
Plugging completed September 17 1962
Reason for abandonment of well or producing formation _____

NORTH

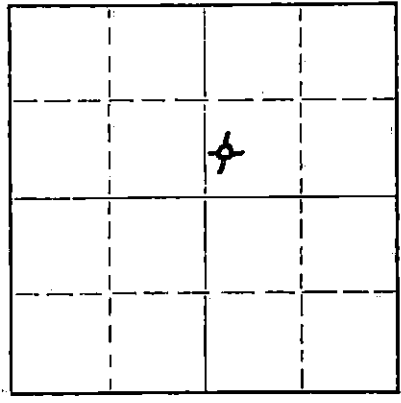

Locate well correctly on above Section Plat

If a producing well is abandoned, date of last production _____ 19____
Was permission obtained from the Conservation Division or its agents before plugging was commenced? Yes

Name of Conservation Agent who supervised plugging of this well Herman Justice
Producing formation _____ Depth to top _____ Bottom _____ Total Depth of Well 4867 Feet
Show depth and thickness of all water, oil and gas formations.

OIL, GAS OR WATER RECORDS CASING RECORD

FORMATION	CONTENT	FROM	TO	SIZE	PUT IN	PULLED OUT
				13 3/8" OD	200'	None
				8 5/8" OD	900'	644'

Describe in detail the manner in which the well was plugged, indicating where the mud fluid was placed and the method or methods used in introducing it into the hole. If cement or other plugs were used, state the character of same and depth placed, from _____ feet to _____ feet for each plug set.

Filled hole with heavy mud from 4867' TD to 840' pushed plug and one sack of hulls to 840' and pumped in 20 sacks of cement on top of plug.
Filled hole with mud to 180' pushed plug and one sack of hulls to 180' and dumped in 30 sacks of cement.
Filled hole with mud to 30' pushed plug and one sack of hulls to 30' and dumped in 10 sacks of cement filling hole to bottom of cellar.

RECEIVED
STATE CORPORATION COMMISSION
SEP 21 1962
CONSERVATION DIVISION
WICHITA, KANSAS
9-21-1962

(If additional description is necessary, use BACK of this sheet)

Name of Plugging Contractor H-30 Drilling Inc. (Rotary)
Address 709 Petroleum Building, Wichita, Kansas

STATE OF Kansas, COUNTY OF Barton, ss.
J. W. Meyers (employee of owner) or (~~owner~~) of the above-described well, being first duly sworn on oath, says: That I have knowledge of the facts, statements, and matters herein contained and the log of the above-described well as filed and that the same are true and correct. So help me God.
(Signature) J. W. Meyers
Box 308, Ellinwood, Kansas
(Address)

SUBSCRIBED AND SWORN TO before me this 20th day of September, 19 62

My commission expires 5-22-66
M. Bennett Stone Notary Public.

Champlin Oil & Refining Co.
Davis Ranch J #2
5' North of W $\frac{1}{2}$ - SW - NE
Sec. 12-34S-15W
Barber County, Kansas

Formation Log

0' - 40'	Surface, sand & shale
40' - 200'	Shale & shells
200' - 415'	Redbed, shale & shells
415' - 1320'	Redbed & shale
1320' - 1790'	Shale & shells
1790' - 1915'	Shale & lime
1915' - 2415'	Lime & shale
2415' - 2535'	Shale & lime
2535' - 2655'	Lime & shale
2655' - 3435'	Shale & lime
3435' - 3716'	Lime & shale
3716' - 4115'	Shale & lime
4115' - 4160'	Lime & shale
4160' - 4200'	Shale & lime
4200' - 4775'	Lime
4775' - 4790'	Lime & shale
4790' - 4867'	Lime
4867'	Total Depth

RECEIVED
STATE CORPORATION COMMISSION
SEP 21 1964
CONSERVATION DIVISION
Wichita, Kansas