


Give All Information Completely
Make Required Affidavit.
Mail or Deliver Report to:
Conservation Division
State Corporation Commission
211 No. Broadway
Wichita, Kansas

WELL PLUGGING RECORD

NORTH

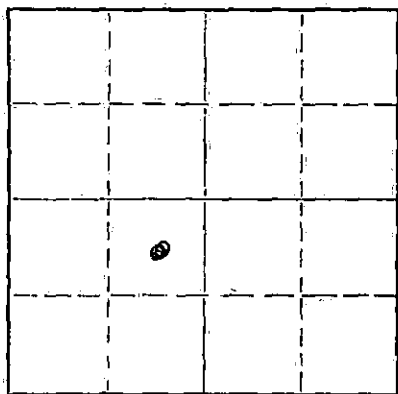

Locate well correctly on above
Section Plat

Barber County, Sec. 26 Twp. 34 Rge. 13W(E) (W)
Location as "NE/CNWSW" or footage from lines SW
Lease Owner Mr. Ray Stekoll, Wichita Iron & Metal
Lease Name Allen Well No. # 1
Office Address P. O. Box 2121 Wichita, Kansas
Character of Well (completed as Oil, Gas or Dry Hole)
Date well completed 19
Application for plugging filed yes 19
Application for plugging approved yes 19
Plugging commenced 11-29-61 19
Plugging completed 12-3-61 19
Reason for abandonment of well or producing formation

If a producing well is abandoned, date of last production 19
Was permission obtained from the Conservation Division or its agents before plugging was commenced? yes

Name of Conservation Agent who supervised plugging of this well Hampel
Producing formation Depth to top Bottom Total Depth of Well 3640' Feet
Show depth and thickness of all water, oil and gas formations.

OIL, GAS OR WATER RECORDS

CASING RECORD

FORMATION	CONTENT	FROM	TO	SIZE	PUT IN	PULLED OUT
				5 1/2"		2710'

Describe in detail the manner in which the well was plugged, indicating where the mud fluid was placed and the method or methods used in introducing it into the hole. If cement or other plugs were used, state the character of same and depth placed, from feet to feet for each plug set.

Plugging commenced 11-29-61. Plugging completed 12-3-61.

Measured in to total depth: 3640'.

Sanded back to 3600' and dumped 5 sacks cement.

Worked & shot 5 1/2" casing free at 2710'. Built rack & slide.
Pulled & layed down casing. Bailed down hole.

Mudded up to 250' and set 10' rock bridge. Dumped 20 sacks
cement. Mudded up to 40' and set 10' rock bridge.
Capped the well with 10 sacks cement.

RECEIVED
STATE CORPORATION COMMISSION

DEC 11 1961

CONSERVATION DIVISION
Wichita, Kansas

(If additional description is necessary, use BACK of this sheet)

Name of Plugging Contractor Forbes Casing Pulling, Inc.
Address P. O. Box 221 Great Bend, Kansas

STATE OF Kansas, COUNTY OF Barton, ss.
J. O. Forbes (employee of owner) or (owner or operator) of the above-described well, being first duly sworn on oath, says: That I have knowledge of the facts, statements, and matters herein contained and the log of the above-described well as filed and that the same are true and correct. So help me God.

(Signature) J. O. Forbes
Great Bend, Kansas (Address)

SUBSCRIBED AND SWORN TO before me this 6th day of December, 1961

My commission expires December 8th, 1963

Kayann Jenkins
Kayann Jenkins Notary Public

WELL LOG BUREAU—KANSAS GEOLOGICAL SOCIETY
503 East Murdock, Wichita, Kansas


COPY

Company- Aurora Gasoline Company & N. Appleman
Farm- Allen No. 1

SEC. 26 T. 34 R.13W
C NE SW

Total Depth. 3634 ft.
Comm. 9-21-57 Comp. 10-1-57
Shot or Treated.
Contractor. Barbour Drilling Co.,
Issued 12-21-57

County Barber KANSAS

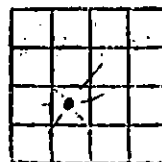

CASING:
8 5/8" @ 252' w/225 sks. cem.
5 1/2" @ 3634' w/125 sks. cem.

Elevation. 1490'
Production. 21,000,000 CFG.

Figures indicate Bottom of Formations.

surface clay	20
red bed	254
red bed, shale & shells	675
shale & shells	1225
shale & lime strks.	1590
Anhydrite & shale	1670
Anhydrite	1800
shale & lime	1925
lime	2650
lime & shale	2861
lime	2960
lime & shale	3170
lime	3470
lime & shale	3620
sand	3634
Total Depth.	

TOPS SCOUT:

Elgin	3616
Elgin Sand	3630

RECEIVED
STATE CORPORATION COMMISSION
FEB 1 1962
CONSERVATION DIVISION
Wichita, Kansas