

STATE OF KANSAS  
STATE CORPORATION COMMISSION


Form CP-4

Give All Information Completely  
Make Required Affidavit  
Mail or Deliver Report to:  
Conservation Division  
State Corporation Commission  
212 No. Market  
Wichita, Kansas 67202

WELL PLUGGING RECORD

Morton County, Sec. 3 Twp. 34S Rge. 42 XXXXX (W)

Location as "NE/CNW/SW" or footage from lines SW/4 NW/4  
Lease Owner Evans & Trigg  
Lease Name Government Well No. 1-3  
Office Address 410 Woolworth Building, Boulder, Colorado 80302  
Character of Well (completed as Oil, Gas or Dry Hole) Dry Hole  
Date well completed 1-12 19 71  
Application for plugging filed 1-12 19 71  
Application for plugging approved 1-18-71 19 71  
Plugging commenced 1-12 19 71  
Plugging completed 1-12 19 71  
Reason for abandonment of well or producing formation No commercial zones of oil or gas encountered in this well  
If a producing well is abandoned, date of last production 19  
Was permission obtained from the Conservation Division or its agents before plugging was commenced? Yes

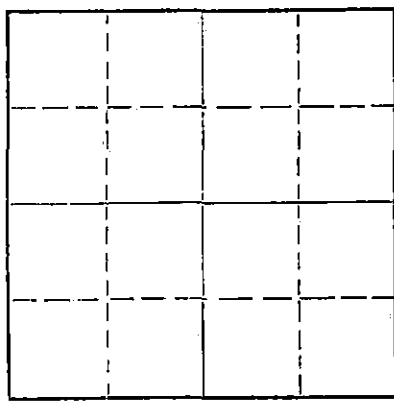

Locate well correctly on above Section Plat

Name of Conservation Agent who supervised plugging of this well Mr. E. Eves  
Producing formation \_\_\_\_\_ Depth to top \_\_\_\_\_ Bottom \_\_\_\_\_ Total Depth of Well \_\_\_\_\_ Feet  
Show depth and thickness of all water, oil and gas formations.

OIL, GAS OR WATER RECORDS

CASING RECORD

| FORMATION | CONTENT | FROM | TO | SIZE   | PUT IN | PULLED OUT |
|-----------|---------|------|----|--------|--------|------------|
| Dakota    | water   |      |    | 8 5/8" | 1245'  | none       |
|           |         |      |    |        |        |            |
|           |         |      |    |        |        |            |
Describe in detail the manner in which the well was plugged, indicating where the mud fluid was placed and the method or methods used in introducing it into the hole. If cement or other plugs were used, state the character of same and depth placed, from \_\_\_\_\_ feet to \_\_\_\_\_ feet for each plug set.

Filled hole with heavy mud. Cement plug of 35 sacks placed in bottom of surface pipe at 1200 feet. Cement plug of 15 sacks placed in top of surface pipe to 45 feet. Surface marker placed in top of surface pipe.

RECEIVED  
STATE CORPORATION COMMISSION  
JAN 27 1971  
CONSERVATION DIVISION  
Wichita, Kansas

(If additional description is necessary, use BACK of this sheet)

Name of Plugging Contractor Davis Drlg. Inc.  
Address American State Bank Building, Great Bend, Kansas

STATE OF Colorado, COUNTY OF Boulder, ss.  
Jack E. Trigg (employee of owner) or (owner or operator) of the above-described

well, being first duly sworn on oath, says: That I have knowledge of the facts, statements, and matters herein contained and the log of the above-described well as filed and that the same are true and correct. So help me God.

(Signature) Jack E. Trigg  
410 Woolworth Bldg. Boulder, Colorado  
(Address)

SUBSCRIBED AND SWORN TO before me this 15th day of January, 1971

My commission expires 12-5-73

Mary L. Fisher  
Notary Public.